

**SURVEY &
REMONUMENTATION**

FEB 08 1999

SECTION

**BRANCH COUNTY REMONUMATION PROGRAM
LAND CORNER RECORDATION CERTIFICATE
Filing Requirement of Act 74, Mich. P.A. 1970**

For corners in

<u>BRANCH COUNTY</u> BUTLER TWP	Located In:	Corner Code #
1. Public Land Survey	<u>T 5 S R 5 W</u>	<u>A-5</u>
	T ___ R ___	___
	T ___ R ___	___
	T ___ R ___	___
2. Property Controlling in Section	S ___ T ___ R ___	___
	S ___ T ___ R ___	___
3. Miscellaneous	S ___ T ___ R ___	___
Property in Sec.	S ___ T ___ R ___	___
4. Lot No. _____, Recorded Plat _____		
5. Private Claims _____		

STATE OF MICHIGAN
Branch County
Recorded

11-04-1998 15:45:34

Linda Lee Morrison-Mathews
REGISTER OF DEEDS

Register of Deeds Stamp & File Number

	A	B	C	D	E	F	G	H	I	J	K	L	M
1													
2	6		5		4		3		2		1		
3													
4	7		8		9		10		11		12		
5													
6	18		17		16		15		14		13		
7													
8	19		20		21		22		23		24		
9													
10	30		29		28		27		26		25		
11													
12	31		32		33		34		35		36		
13													

I, EDWARD W. REED, in a field survey on AUGUST 28, 1998 do hereby state that under requirements of P.A. 74, Michigan P.A. of 1970, the corner points mentioned in lines 1 and 2 above were in conformance with regulations and rules therefore as required in the current manual of survey instructions of the United States Department of the Interior, Bureau of Land Management or by a decree of a Court of Law and /or that the corner points mentioned in lines 3, 4 and 5 above were in conformance with the rules of the Michigan Board of Land Surveyors or by a Decree of a Court of Law; established, re-established, monumented, recovered, found as expressed below:

NOTE: Not more than 2 corners, all in the same town and range, may be recorded on this certificate.

SOUTHWEST CORNER, SECTION 7
NORTHWEST CORNER, SECTION 18

A. Description of original monument and accessories and/or subsequent restoration:

1825: R. CLARK JR. D.S. CORNER SET
1977: E.R. REED: RESET CORNER USING NE CORNER AND NORTH QUARTER CORNER MONUMENT FOR NORTH LINE AND EXISTING LINES OF OCCUPATION NORTH AND SOUTH. SET 3/4" x 18" SOLID IRON. RECORDED IN LCRC-#205

B. Description of corner evidence found and/or method applied in restoring or reestablishing corner:

FOUND 3/4" x 18" IRON ROD FITTING WITNESS OF LCRC#205


C. Description of monument for corner and accessories established to perpetuate locating the position of the corner:

SET 1/2" X 18" REBAR IRON WITH REMON CAP IN CI - MONUMENT BOX FLUSH WITH PAVED ROAD SURFACE.

8.2' NORTH OF C/L OF BLACKTOP PAVEMENT
IN LINE WITH FENCE RUNNING NORTH
P. POLE N 80 E 131.2' TO FACE
P. POLE N 78 W 181.9' TO FACE
8" MAPLE S 23 W 43.0' TO CENTER

AND IS ACCEPTED AS THE BEST AVAILABLE EVIDENCE OF THE POSITION OF THE ORIGINAL CORNER.

ACCEPTED BY THE BRANCH COUNTY SURVEY PEER GROUP AS THE OFFICIAL CORNER UNDER MICHIGAN PUBLIC ACT 345 OF 1990 AT MEETING HELD ON 9-9-98
E.R. REED, Co. Rep.
E.R. REED

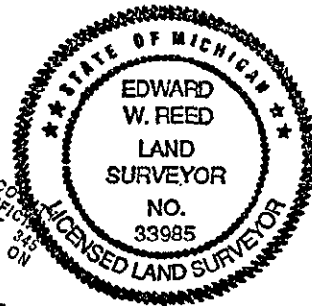

Signed by Edward W. Reed
EDWARD W. REED

Date 9-9-98

Surveyor's Michigan License No. 33985

Liber 00003 Page 0206