

SURVEY & REMONUMENTATION

DEC 28 2000

SECTION

**BRANCH COUNTY REMONUMENTATION PROGRAM
LAND CORNER RECORDATION CERTIFICATE
Filing Requirement of Act 74, Mich. P.A. 1970**

For corners in

<u>BRANCH COUNTY</u> BUTLER TWP	Located In:	Corner Code #
1. Public Land Survey	T <u>5</u> S R <u>6</u> W	<u>B-5</u>
	T _____ R _____	_____
	T _____ R _____	_____
	T _____ R _____	_____
2. Property Controlling In Section	S _____ T _____ R _____	_____
	S _____	_____
	T _____ R _____	_____
3. Miscellaneous	S _____	_____
	T _____ R _____	_____
Property in Sec.	S _____	_____
	T _____ R _____	_____
4. Lot No. _____, Recorded Plat _____		
5. Private Claims _____		

*Seg. 1 - Should be
Range 5W -- re-
recorded in
L4 Pg 0011
to correct
pm*

STATE OF MICHIGAN
Branch County
Recorded
11-04-1998 15:45:48
Linda Lee Morrison-Mathews
REGISTER OF DEEDS Stamp & File Number

ACCEPTED BY THE BRANCH COUNTY
SURVEY PEER GROUP AS THE OFFICIAL
CORNER UNDER MICHIGAN PUBLIC ACT 345
OF 1990 AT MEETING HELD ON

9-09-1998

E.R. Reed Co. Rep

E.R. REED

	A	B	C	D	E	F	G	H	I	J	K	L	M
1													
2		6		5		4		3		2		1	
3													
4		7		8		9		10		11		12	
5													
6		18		17		16		15		14		13	
7													
8		19		20		21		22		23		24	
9													
10		30		29		28		27		26		25	
11													
12		31		32		33		34		35		36	
13													

I, EDWARD W. REED, in a field survey on MAY 6, 19 98 do hereby state that under requirements of P.A. 74, Michigan P.A. of 1970, the corner points mentioned in lines 1 and 2 above were in conformance with regulations and rules therefore as required in the current manual of survey instructions of the United States Department of the Interior, Bureau of Land Management or by a decree of a Court of Law and /or that the corner points mentioned in lines 3, 4 and 5 above were in conformance with the rules of the Michigan Board of Land Surveyors or by a Decree of a Court of Law; established, re-established, monumented, recovered, found as expressed below:

NOTE: Not more than 2 corners, all in the same town and range, may be recorded on this certificate.

QUARTER CORNER COMMON TO SECTIONS 7 & 18

A. Description of original monument and accessories and/or subsequent restoration:

- 1825: R. CLARK, JR. D.S. - CORNER SET
- 1878: M. KNOWLES, CO SURVEYOR - FOUND STONE
- 1977: E.R. REED, CO SURVEYOR - FOUND POINTED STONE IN LINE WITH FENCE LINE RUNNING SOUTH, SET 1/2" X 18" IRON ROD, RECORDED IN LCRC # 0205


B. Description of corner evidence found and/or method applied in restoring or reestablishing corner:

FOUND POINTED STONE WITH 1/2" X 18" IRON ALONG SIDE, AGREEING WITH WITNESS OF LCRC # 205

C. Description of monument for corner and accessories established to perpetuate locating the position of the corner:

SET 1/2" X 18" REBAR IRON WITH REMON CAP IN PLACE OF POINTED STONE, SET CI-MONUMENT BOX 3" BELOW GRAVEL ROAD SURFACE

FENCE LINE RUNNING NORTH	WEST	140.9'
CENTER OF 12" WALNUT	S 5 W	33.8'
FACE OF RR TIE ANCHOR POST	SOUTH	33.2'
CENTER OF HICKORY	S 45 E	48.2'
CENTER OF 36" MAPLE	S 70 E	109.8'

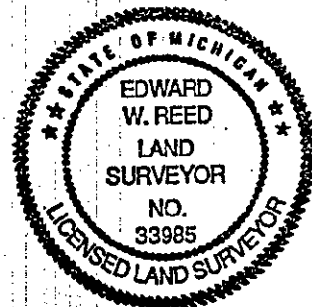

AND IS ACCEPTED AS A CAREFUL AND FAITHFUL PERPETUATION OF THE POSITION OF THE ORIGINAL CORNER.

Signed by Edward W. Reed

Date 9-9-98

EDWARD W, REED

Surveyor's Michigan License No. 33985

Liber 00003 Page 0208