

**SURVEY &
REMONUMENTATION**

FEB 08 1999

**BRANCH COUNTY REMONUMENTATION PROGRAM
LAND CORNER RECORDATION CERTIFICATE
Filing Requirement of Act 74, Mich. P.A. 1970**

SECTION

For corners in

<u>BRANCH COUNTY</u> BUTLER TWP.	Located in:	Corner Code #
1. Public Land Survey	T <u>5 S</u> R <u>5 W</u>	<u>B-9</u>
	T _____ R _____	_____
	T _____ R _____	_____
	T _____ R _____	_____
2. Property Controlling in Section	S _____ T _____ R _____	_____
	S _____	_____
	T _____ R _____	_____
3. Miscellaneous	S _____	_____
	T _____ R _____	_____
Property in Sec.	S _____	_____
	T _____ R _____	_____

STATE OF MICHIGAN
Branch County
Recorded

11-04-1998 15:45:55

Linda Lee Morrison-Mathews
REGISTER OF DEEDS

Register of Deeds Stamp & File Number

ACCEPTED BY THE BRANCH COUNTY
SURVEY PEER GROUP AS THE OFFICIAL
CORNER UNDER MICHIGAN PUBLIC ACT 345
OF 1990 AT A MEETING HELD ON
9-09-1998

E.R. Reed, Co. Rep.

E.R. REED

4. Lot No. _____, Recorded Plat _____

5. Private Claims _____

I, EDWARD W. REED, in a field survey on MAY 6, 1998 do hereby state that under requirements of P.A. 74, Michigan P.A. of 1970, the corner points mentioned in lines 1 and 2 above were in conformance with regulations and rules therefore as required in the current manual of survey instructions of the United States Department of the Interior, Bureau of Land Management or by a decree of a Court of Law and /or that the corner points mentioned in lines 3, 4 and 5 above were in conformance with the rules of the Michigan Board of Land Surveyors or by a Decree of a Court of Law; established, re-established, monumented, recovered, found as expressed below:

NOTE: Not more than 2 corners, all in the same town and range, may be recorded on this certificate.

	A	B	C	D	E	F	G	H	I	J	K	L	M
1													
2		6		5		4		3		2		1	
3													
4		7		8		9		10		11		12	
5													
6		18		17		16		15		14		13	
7													
8		19		20		21		22		23		24	
9													
10		30		29		28		27		26		25	
11													
12		31		32		33		34		35		36	
13													

QUARTER CORNER COMMON TO SECTIONS 19, AND 30

A. Description of original monument and accessories and/or subsequent restoration:

- 1825: R. CLARK, JR., D.S. - CORNER SET
- 1861: M. KNOWLES, DEP. COUNTY SURVEYOR, STONE AND BRICKS
- 1948: H. RUSSELL, COUNTY SURVEYOR, FOUND STONE
- 1986: E.R. REED, COUNTY SURVEYOR, FOUND STONE FITTING WITNESS OF H. RUSSELL, SET 1/2" x 16" IRON ROD OVER STONE, RECORDED IN L.C.R.C. II-0093


B. Description of corner evidence found and/or method applied in restoring or reestablishing corner:

FOUND 1/2 x 16" IRON OVER STONE FITTING WITNESS OF L.C.R.C. II-0093

C. Description of monument for corner and accessories established to perpetuate locating the position of the corner:

SET 1/2" X 18" REBAR IRON WITH REMONUMENTATION CAP IN CI-MONUMENT BOX FLUSH WITH PAVED ROAD SURFACE

FACE OF 2" DIAMETER STEEL ANCHOR POST	N45W 37.7'
NW CORNER OF METAL SIDED BUILDING	S25E 70.0'
NW CORNER OF CORN CRIB	S6W 62.4'
CENTER OF 36" MAPLE	S77W 120.0'
1.2' NORTH OF CENTERLINE OF DAYBURG ROAD	

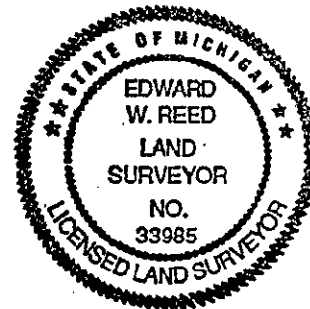

AND IS ACCEPTED AS A CAREFUL AND FAITHFUL PERPETUATION OF THE POSITION OF THE ORIGINAL CORNER.

Signed by *Edward W. Reed*
EDWARD W. REED

Date 9-9-98

Surveyor's Michigan License No. 33985

Liber 000003 Page 0209