

RECORDED

#40911

FEB 03 2000

BRANCH COUNTY REMONUMATION PROGRAM STATE OF MICHIGAN
LAND CORNER RECORDATION CERTIFICATE Branch County
Filing Requirement of Act 74, Mich. P.A. 1970 Recorded

SECTION

For corners in

<u>BRANCH COUNTY</u> BUTLER TWP	Located In:	Corner Code #
1. Public Land Survey	T <u>5 S</u> R <u>5 W</u>	<u>E-01</u>
	T _____ R _____	_____
	T _____ R _____	_____
	T _____ R _____	_____
2. Property Controlling in Section	S _____ T _____ R _____	_____
	S _____	_____
	T _____ R _____	_____
3. Miscellaneous	S _____	_____
	T _____ R _____	_____
Property in Sec.	S _____	_____
	T _____ R _____	_____

11-08-1999 15:11:40

Linda Lee Morrison-Matheus
REGISTER OF DEEDS

Liber 00004 Page 0013

Register of Deeds Stamp & File Number

ACCEPTED BY THE BRANCH COUNTY
SURVEY PEER GROUP AS THE OFFICIAL
CORNER UNDER MICHIGAN PUBLIC ACT 345
OF 1990 AT A MEETING HELD ON
10-06-1999

E.R. Reed, Co. Rep.
E.R. REED

- 4. Lot No. _____, Recorded Plat _____
- 5. Private Claims _____

I, EDWARD W. REED, in a field survey on SEPTEMBER 20, 19 99 do hereby state that under requirements of P.A. 74, Michigan P.A. of 1970, the corner points mentioned in lines 1 and 2 above were in conformance with regulations and rules therefore as required in the current manual of survey instructions of the United States Department of the Interior, Bureau of Land Management or by a decree of a Court of Law and /or that the corner points mentioned in lines 3, 4 and 5 above were in conformance with the rules of the Michigan Board of Land Surveyors or by a Decree of a Court of Law; established, re-established, monumented, recovered, found as expressed below:

NOTE: Not more than 2 comers, all in the same town and range, may be recorded on this certificate.

NE CORNER SECTION 5 - NW CORNER SECTION 4 - BUTLER TWP.

A. Description of original monument and accessories and/or subsequent restoration:

- 1825: ROBERT. CLARK JR, - CORNER SET
- 1911: W.W. COX - SET CORNER 59 LINKS EAST OF CALHOUN CO. CORNER - SET PLOW POINT LANDSIDE, WITH BRICK AROUND - NO WITNESS.

B. Description of corner evidence found and/or method applied in restoring or reestablishing corner:

FOUND STONE & BRICK AND LANDSIDE EAST OF CALHOUN CORNER.

C. Description of monument for corner and accessories established to perpetuate locating the position of the corner:

SET 1/2"X18" REBAR IRON ALONG SIDE OF STONE IN CI-MONUMENT BOX 5" BELOW GRAVEL ROAD SURFACE.

NW CORNER TEL PED.	S33E	51.67'
C/L E-W GRAVEL RD.	SOUTH	3'
POWER POLE	S12W	187.86'
CENTER OF 8" MAPLE	S84W	138.2'
CENTER OF 24' CHERRY	S73E	124.4'


AND IS ACCEPTED AS A CAREFUL AND FAITHFUL PERPETUATION OF THE POSITION OF THE ORIGINAL CORNER.

Signed by Edward W. Reed

EDWARD W. REED

Date SEPTEMBER 20, 1999

Surveyor's Michigan License No. 33985

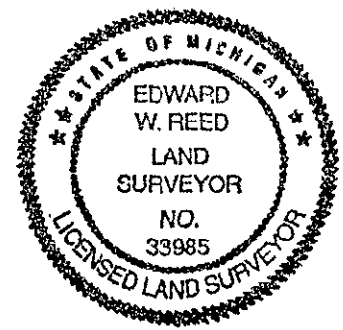

	A	B	C	D	E	F	G	H	I	J	K	L	M
1													
2	6			5		4		3		2		1	
3													
4	7			8		9		10		11		12	
5													
6	18			17		16		15		14		13	
7													
8	19			20		21		22		23		24	
9													
10	30			29		28		27		26		25	
11													
12	31			32		33		34		35		36	
13													