

FEB 02 2000

BRANCH COUNTY REMONUMATION PROGRAM  
LAND CORNER RECORDATION CERTIFICATE  
Filing Requirement of Act 74, Mich. P.A. 1970

SECTION

For corners in

<u>BRANCH COUNTY</u>	Located In:	Corner Code #
BUTLER TWP		
1. Public Land Survey	T <u>5</u> S R <u>5</u> W	<u>K-3</u>
	T _____ R _____	_____
	T _____ R _____	_____
	T _____ R _____	_____
2. Property Controlling in Section	S _____ T _____ R _____	_____
	S _____	_____
	T _____ R _____	_____
3. Miscellaneous	S _____	_____
	T _____ R _____	_____
Property in Sec.	S _____	_____
	T _____ R _____	_____

STATE OF MICHIGAN  
Branch County  
Recorded

11-08-1999 15:12:05

Linda Lee Morrison-Mathews  
REGISTER OF DEEDS

Liber 00004 Page 0015  
Register of Deeds Stamp & File Number

4. Lot No. \_\_\_\_\_, Recorded Plat \_\_\_\_\_

5. Private Claims \_\_\_\_\_

I, EDWARD W. REED, in a field survey on SEPTEMBER 20, 19 99 do hereby state that under requirements of P.A. 74, Michigan P.A. of 1970, the corner points mentioned in lines 1 and 2 above were in conformance with regulations and rules therefore as required in the current manual of survey instructions of the United States Department of the Interior, Bureau of Land Management or by a decree of a Court of Law and /or that the corner points mentioned in lines 3, 4 and 5 above were in conformance with the rules of the Michigan Board of Land Surveyors or by a Decree of a Court of Law; established, re-established, monumented, recovered, found as expressed below:

NOTE: Not more than 2 comers, all in the same town and range, may be recorded on this certificate.

CORNER COMMON TO SECTIONS 1, 2, 11 & 12, BUTLER TOWNSHIP, BRANCH COUNTY, MICHIGAN

	A	B	C	D	E	F	G	H	I	J	K	L	M
1													
2	6		5		4			3		2		1	
3											●		
4	7		8		9		10		11		12		
5													
6	18		17		16		15		14		13		
7													
8	19		20		21		22		23		24		
9													
10	30		29		28		27		26		25		
11													
12	31		32		33		34		35		36		
13													

ACCEPTED BY THE BRANCH COUNTY SURVEY PEER GROUP AS THE OFFICIAL CORNER UNDER MICHIGAN PUBLIC ACT 345 OF 1990 AT A MEETING HELD ON 10-06-1999

E.R. Reed, Co. Rep.  
E.R. REED

A. Description of original monument and accessories and/or subsequent restoration:

1825: ROB'T CLARK, JR., D.S., CORNER SET  
OLD NOTES INDICATE: STONE & BRICK, PROBABLY BY A.R. DAY, SURVEYOR


B. Description of corner evidence found and/or method applied in restoring or reestablishing corner:

FOUND STONE & BRICK  
SET 1/2" X 18" IRON WITH REMON CAP ALONG SOUTH SIDE OF STONE  
SET CAST IRON MONUMENT BOX 4" BELOW GRAVEL ROAD SURFACE

C. Description of monument for corner and accessories established to perpetuate locating the position of the corner:

1/2" X 18" IRON WITH REMON CAP IN CAST IRON BOX 4" BELOW GRAVEL ROAD SURFACE/

IN LINE WITH FENCE LINE SOUTH	
IN LINE WITH FENCEPOSTS NORTH	
SOUTH 18.46'	RR TIE POST
NORTH 33.54'	CENTER OF ROAD CONCRETE
N 3 E 31.97'	TELEPHONE PEDESTAL
N 29 E 135.90'	SW CORNER OF HOUSE
SOUTH 41.5'	CENTER OF 60" TWIN BUTTERNUT
FOUND NEW 1/2" IRON DUE EAST 5.95'	

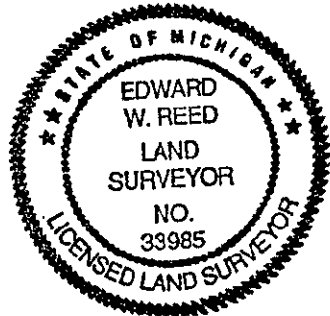

AND IS ACCEPTED AS A CAREFUL AND FAITHFUL PERPETUATION OF THE POSITION OF THE ORIGINAL CORNER.

Signed by Edward W. Reed

Date SEPTEMBER 20, 1999

EDWARD W. REED

Surveyor's Michigan License No. 33985