

# SURVEY & REMONUMENTATION

MAR 21 1997

COMMISSION

## BRANCH COUNTY REMONUMENTATION CORNER LAND CORNER RECORDATION CERTIFICATE

Filing Requirement of Act 74, Mich. P.A. 1970

STATE OF MICHIGAN  
Branch County  
Recorded

12-30-1996 14:12:22

Linda Lee Morrison-Mathews  
REGISTER OF DEEDS

Liber **00003** Page **0114**  
Register of Deeds Stamp & File Number

For corners in

<u>BRANCH</u>	Located In:	Corner Code #/
(County)		
<u>BUTLER TWP.</u>		
1. Public Land Survey	T <u>5</u> S R <u>5</u> W	<u>K-7</u>
	T _____ R _____	_____
	T _____ R _____	_____
	T _____ R _____	_____
2. Property Controlling in Section	S _____ T _____ R _____	_____
	S _____ T _____ R _____	_____
3. Miscellaneous Property in Sec.	S _____ T _____ R _____	_____
	S _____ T _____ R _____	_____

4. Lot No. \_\_\_\_\_, Recorded Plat \_\_\_\_\_
5. Private Claims \_\_\_\_\_

	A	B	C	D	E	F	G	H	I	J	K	L	M
2	6	5	4	3	2	1							
3													
4	7	8	9	10	11	12							
5													
6	18	17	16	15	14	13							
7													
8	19	20	21	22	23	24							
9													
10	30	29	28	27	26	25							
11													
12	31	32	33	34	35	36							
13													

I, EDWARD W. REED, in a field survey on NOVEMBER 7, 19 96, do hereby certify that under requirements of P.A. 74, Michigan P.A. of 1970, the corner points mentioned in lines 1 and 2 above were in conformance with regulations and rules therefore as required in the current manual of survey instructions of the United States Department of the Interior, Bureau of Land Management or by a decree of a Court of Law and/or that the corner points mentioned in lines 3, 4 and 5 above were in conformance with the rules of the Michigan Board of Land Surveyors or by a Decree of a Court of Law; established, re-established, monumented, re-monumented, recovered, found as expressed below:

**NOTE: Not more than 4 corners, all in the same town and range, may be recorded on this certificate.**

**A. Description of original monument and accessories and/or subsequent restoration:**


- CORNER COMMON TO SECTIONS 13, 14, 23, & 24, T5S, R5W, BUTLER TWP., BRANCH COUNTY, MI
- 1826: R. CLARK, JR., DEP. SURVEYOR, CORNER SET
- 1889: BENNETT, FOUND STONE WELL PLANTED WITH BRICK & PLOW POINT AROUND
- 1916: C.B. NORTON, DEP. COUNTY SURVEYOR, FOUND OLD STONE SURROUNDED BY COBBLES & PLOW POINT
- 1935: E.L. MINER, FOUND STONE AS DESCRIBED IN LIBER 4, PAGE 14

**B. Description of corner evidence found and/or method applied in restoring or reestablishing corner:**

FOUND THE POINTED STONE & OLD PLOW POINT AGREEING WITH 1 OLD WITNESS  
SET 1/2" 12" REBAR & REMONUMENTATION CAP. SET CAST IRON BOX 1 1/2" BELOW GRAVEL ROAD GRADE

ACCEPTED BY THE BRANCH COUNTY  
SURVEY PEER GROUP AS THE OFFICIAL  
CORNER UNDER MICHIGAN PUBLIC ACT 345  
OF 1990 AT A MEETING HELD ON  
Nov. 13, 1996

*E. A. Reed Co. Rep.*  
**E.R. REED**

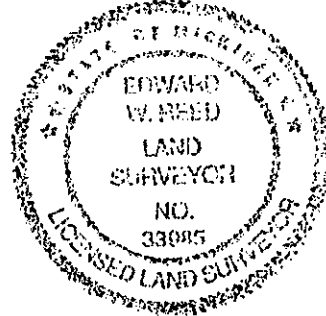

**C. Description of monument for corner and accessories established to perpetuate locating the position of the corner:**

- 1/2" x 12" REBAR WITH REMONUMENTATION CAP IN CAST IRON BOX
- S69W 143 LINKS (94.38') TO FACE OF TWIN WHITE OAK
- N60E 62.63' TO NAIL & WASHER 2' UP S SIDE OF 14" HICKORY
- S66W 63.40' TO NAIL & WASHER ON POWER POLE
- N40W 42.85' TO SE CORNER OF TELEPHONE PEDESTAL

AND IS ACCEPTED AS A CAREFUL AND FAITHFUL PERPETUATION OF THE POSITION OF THE ORIGINAL CORNER.

Signed by *Edward W. Reed*  
**EDWARD W. REED**  
Surveyor's Michigan License No. 33985

Date NOVEMBER 8, 1996