RE... FEB 0 2 2000

SECTION

BRANCH COUNTY REMONUMENTATION PROGRAM
LAND CORNER RECORDATION CERTIFICATE
Filing Requirement of Act 74, Mich. P.A. 1970

STATE OF MICHIGAN
Branch County
Recorded

12-30-1999 11:01:01

Linda Lee Morrison-Mathews
REGISTER OF DEEDS

Liber 00004 Page 0051

Register of Deeds Stamp & File Number

ACCEPTED BY THE BRANCH COUNTY SURVEY PEER GROUP AS THE OFFICIAL CORNER UNDER MICHIGAN PUBLIC ACT 345 OF 1990 AT A MEETING HELD ON DEC. 07, 1999.

E.R. Reed, P.S.
E.R. REED

For corners in

BRANCH COUNTY
BUTLER TWP

	Located In:	Corner Code #
1. Public Land Survey	T 5 S R 5 W	M-1
	T___ R___	
	T___ R___	
	T___ R___	
2. Property Controlling	S___ T___ R___	
in Section	S___	
	T___ R___	
3. Miscellaneous	S___	
	T___ R___	
Property in Sec.	S___	
	T___ R___	

4. Lot No. _____ , Recorded Plat _____

5. Private Claims _____

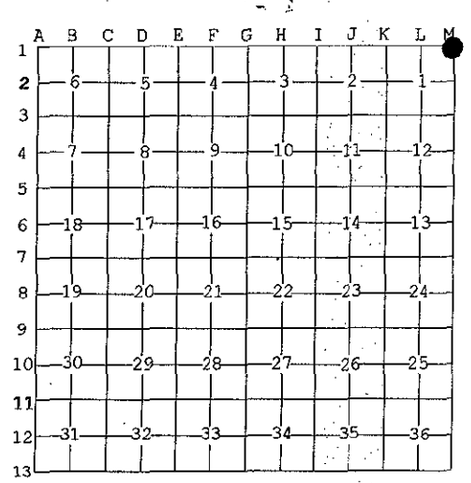

I, EDWARD W. REED, in a field survey on OCT. 20, 19 99 do hereby state that under requirements of P.A. 74, Michigan P.A. of 1970, the corner points mentioned in lines 1 and 2 above were in conformance with regulations and rules therefore as required in the current manual of survey instructions of the United States Department of the Interior, Bureau of Land Management or by a decree of a Court of Law and /or that the corner points mentioned in lines 3, 4 and 5 above were in conformance with the rules of the Michigan Board of Land Surveyors or by a Decree of a Court of Law; established, re-established, monumented, recovered, found as expressed below:

NOTE: Not more than 2 corners, all in the same town and range, may be recorded on this certificate.

CORNER COMMON TO BRANCH, HILLSDALE, AND CALHOUN

A. Description of original monument and accessories and/or subsequent restoration:

1825: JOHN MULLETT - CORNER SET

B. Description of corner evidence found and/or method applied in restoring or reestablishing corner:

FOUND IRON PIPE & FLAGGING OVER STONE FITTING OLD FENCELINE SOUTH
SET ½" X 18" REBAR IRON IN CAST IRON MONUMENT BOX SET FLUSH WITH PAVED ROAD SURFACE

C. Description of monument for corner and accessories established to perpetuate locating the position of the corner:

MAPLE 48"	DUE SOUTH 22.6'
TELEPHONE PEDESTAL	N57W 79.5'
POWER POLE	N25W 130.8'
POWER POLE	N24E 127.0'

5.7' SOUTH OF EAST-WEST ROAD CENTERLINE
35.1' EAST OF NORTH ROAD CENTERLINE

STATE OF MICHIGAN
EDWARD W. REED
LAND SURVEYOR
NO. 33985
LICENSED LAND SURVEYOR

AND IS ACCEPTED AS A CAREFUL AND FAITHFUL PERPETUATION OF THE POSITION OF THE ORIGINAL CORNER.

Signed by Edward W. Reed Date OCT 20, 1999

EDWARD W. REED

Surveyor's Michigan License No. 33985

FORM APPROVED BY MICHIGAN STATE BOARD OF PROFESSIONAL SURVEYORS, JAN. 28, 1971
REVISED MAY 14,1975
REVISED JAN., 1983
REVISED OCT., 1995