342600

SURVEY & REMONUMENTATION

OCT 1 2 1999

SECTION

BRANCH COUNTY REMONUMATION PROGRAM
LAND CORNER RECORDATION CERTIFICATE
Filing Requirement of Act 74, Mich. P.A. 1970

STATE OF MICHIGAN
Branch County
Recorded

09-29-1999 11:59:16

Linda Lee Morrison-Mathews
REGISTER OF DEEDS

Register of Deeds Stamp & File Number

ACCEPTED BY THE BRANCH COUNTY SURVEY PEER GROUP AS THE OFFICIAL CORNER UNDER MICHIGAN PUBLIC ACT 345 OF 1990 AT A MEETING HELD ON 9-09-1998

E.R. Reed, Co. Rep.

For corners in

BRANCH COUNTY
BUTLER TWP

	Located In:	Corner Code #
1. Public Land Survey	T 5 S R 5 W	B-5
	T____ R____	
	T____ R____	Sec. 2
	T____ R____	
2. Property Controlling in Section	S____ T____ R____	
	S____	
	T____ R____	
3. Miscellaneous	S____	
	T____ R____	
Property in Sec.	S____	
	T____ R____	

4. Lot No. _____ , Recorded Plat _____

5. Private Claims _____

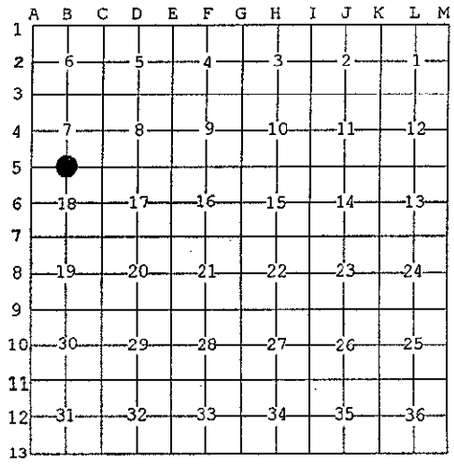

I, EDWARD W. REED, in a field survey on MAY 6, 19 98 do hereby state that under requirements of P.A. 74, Michigan P.A. of 1970, the corner points mentioned in lines 1 and 2 above were in conformance with regulations and rules therefore as required in the current manual of survey instructions of the United States Department of the Interior, Bureau of Land Management or by a decree of a Court of Law and /or that the corner points mentioned in lines 3, 4 and 5 above were in conformance with the rules of the Michigan Board of Land Surveyors or by a Decree of a Court of Law; established, re-established, monumented, recovered, found as expressed below:

NOTE: **Not more than 2 corners, all in the same town and range, may be recorded on this certificate.**

QUARTER CORNER COMMON TO SECTION 7 & 18

A. Description of original monument and accessories and/or subsequent restoration:
1825: R. CLARK, JR., D.S.-CORNER SET
1878: M. KNOWLES, CO SURVEYOR-FOUND STONE
1977: E.R. REED, CO SURVEYOR-FOUND POINTED STONE IN LINE WITH FENCE LINE RUNNING SOUTH, SET ½ X 18" IRON ROD, RECORDED IN LCRC #0205

B. Description of corner evidence found and/or method applied in restoring or reestablishing corner:
FOUND POINTED STONE WITH ½" X 18" IRON ALONG SIDE, AGREEING WITH WITNESS OF LCRC #205

C. Description of monument for corner and accessories established to perpetuate locating the position of the corner:
SET ½" X 18" REBAR IRON WITH REMON CAP IN PLACE OF POINTED STONE, SET CI MONUMENT BOX 3" BELOW GRAVEL ROAD SURFACE

FENCE LINE RUNNING NORTH	WEST	140.9'
CENTER OF 12" WALNUT	S 5 W	33.8'
FACE OF RR TIE ANCHOR POST	SOUTH	33.2'
CENTER OF HICKORY	S 45 E	48.2'
CENTER OF 36" MAPLE	S 70 E	109.8'

AND IS ACCEPTED AS A CAREFUL AND FAITHFUL PERPETUATION OF THE POSITION OF THE ORIGINAL CORNER

STATE OF MICHIGAN
EDWARD W. REED
LAND SURVEYOR
NO. 33985
LICENSED LAND SURVEYOR

Signed by Edward W. Reed
EDWARD W. REED

Date SEPTEMBER 9, 1998

Surveyor's Michigan License No. 33985

Liber 00004 Page 0011

THIS IS A RE-RECORDING OF LCRC RECORDED FEB. 8, 1999, IN LIBER 00003, PAGE 0208, BRANCH COUNTY REGISTER'S OFFICE.

FORM APPROVED BY MICHIGAN STATE BOARD OF PROFESSIONAL SURVEYORS, JAN. 28, 1971
REVISED MAY 14,1976
REVISED JAN., 1983
REVISED OCT., 1995