

# SURVEY & REMONUMENTATION

ACCEPTED BY THE BRANCH COUNTY  
SURVEY PEER GROUP AS THE OFFICIAL  
CORNER UNDER MICHIGAN PUBLIC ACT 345  
OF 1990 AT A MEETING HELD ON  
12-16-94

APR 26 1995

BRANCH COUNTY REMONUMENTATION CORNER

LAND COMMISSION CERTIFICATE

**COMMISSION**

Filing Requirement of Act 74, Mich. P.A. 1970

For corners in

BRANCH <small>(County)</small>	Located In:	Corner Code --//
QUINCY TWP.		
1. Public Land Survey	T <u>6</u> SR <u>5</u> W	<u>B - 11</u>
	T _____ R _____	_____
	T _____ R _____	_____
	T _____ R _____	_____
2. Property Controlling in Section	S _____ T _____ R _____	_____
	S _____ T _____ R _____	_____
3. Miscellaneous Property in Sec.	S _____ T _____ R _____	_____
	S _____ T _____ R _____	_____
4. Lot No. _____, Recorded Plat _____		
5. Private Claims _____		

STATE OF MICHIGAN  
Branch County  
Recorded

12-28-1994 15:03:19

Linda Lee Morrison-Mathews  
REGISTER OF DEEDS

Registrar of Deeds Stamp & File Number  
**00002 0307**

I, EDWARD R. REED, in a field survey on SEPTEMBER 6, 19 94, do hereby certify that under requirements of P.A. 74, Michigan P.A. of 1970, the corner points mentioned in lines 1 and 2 above were in conformance with regulations and rules therefore as required in the current manual of survey instructions of the United States Department of the Interior, Bureau of Land Management or by a decree of a Court of Law and/or that the corner points mentioned in lines 3, 4 and 5 above were in conformance with the rules of the Michigan Board of Land Surveyors or by a Decree of a Court of Law; established, re-established, monumented, re-monumented, recovered, found as expressed below:

**NOTE: Not more than 4 corners, all in the same town and range, may be recorded on this certificate.**

A. Description of original monument and accessories and/or subsequent restoration:  
B-11: **QUARTER CORNER 30-31, T6S, R5W, QUINCY TWP.**

GLO = O. RISDON, D.S., 1829: "WEST BETWEEN SECS. 30 & 31 40.00 SET QTR SEC POST W MAPLE 18 S40E 101 B ASH E 104"

BENNETT, 1874: (NO INFORMATION ON SURVEY REGARDING THIS CORNER).

M. KNOWLES, DEP. CO. SURVEYOR, 1883: "FOUND STAKE".

E. R. REED, CO. SURVEYOR, 1960: "R.R. SPIKE".

E. R. REED, CO. SURVEYOR, 1980: LCRC# 011 - "FD. IRON STAKE UNDER BLACKTOP SURFACE USED BY RUSSELL & MYSELF FOR PAST 30 YEARS AS SECTION CORNER".

D. A. ANKRON, L.S.#21265, 1980: "FOUND RECORDED IRON ROD..."

B. Description of corner evidence found and/or method applied in restoring or reestablishing corner:

FOUND R.R. SPIKE AND IRON STAKE BELOW SAME, UNDER BLACKTOP PAVEMENT, FROM OLD WITNESSES. I ACCEPTED THIS AS THE CAREFUL AND FAITHFUL PERPETUATION OF THE POSITION OF THE ORIGINAL CORNER.

SET 1/2" X 18" REBAR IRON ROD WITH BRANCH COUNTY REMONUMENTATION CAP, IN CI MONUMENT BOX, TO SURFACE OF NEW PAVEMENT.

C. Description of monument for corner and accessories established to perpetuate locating the position of the corner:

SET 1/2" X 18" REBAR IRON ROD WITH BRANCH COUNTY REMONUMENTATION CAP, IN CI MONUMENT BOX, TO SURFACE OF NEW PAVEMENT.

CENTER N. END CMP CULVERT, N55W 35.4'

TEL. PEDESTAL, N40E 47.0' TO SW CORNER.


IN LINE WITH FENCELINE RUNNING EAST

STEEL L-IRON CORNER POST, EAST 28.1'


P. POLE, S45W 98.3' TO FACE.

4' WEST OF C/L NORTH-SOUTH ROAD PAVEMENT.

AND IS ACCEPTED AS THE CAREFUL AND FAITHFUL PERPETUATION OF THE POSITION OF THE ORIGINAL CORNER.

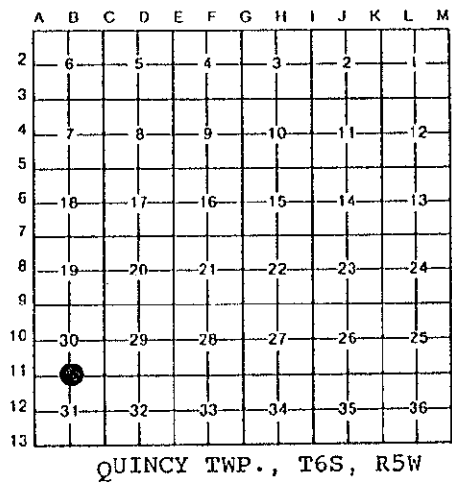

Signed by Edward R. Reed  
Surveyor's Michigan License No. 7437  
EDWARD R. REED

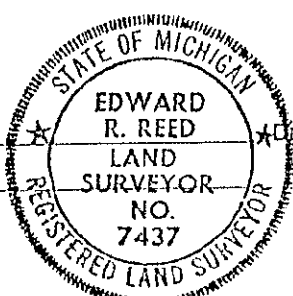

Date SEPTEMBER 6, 1994