

# SURVEY & REMONUMENTATION

MAR 13 1998

## BRANCH COUNTY REMONUMENTATION CORNER LAND CORNER RECORDATION CERTIFICATE

STATE OF MICHIGAN  
Branch County  
Recorded

For corners in SECTION \_\_\_\_\_

BRANCH <small>(County)</small>	Located In:	Corner Code #
QUINCY TWP.	T <u>6</u> S <u>R</u> 5 W	<u>G-9</u>
1. Public Land Survey	T _____ R _____	_____
	T _____ R _____	_____
	T _____ R _____	_____
2. Property Controlling in Section	S _____ T _____ R _____	_____
	S _____ T _____ R _____	_____
3. Miscellaneous Property in Sec.	S _____ T _____ R _____	_____
	S _____ T _____ R _____	_____

10-22-1997 09:58:03

Linda Lee Morrison-Mathews  
REGISTER OF DEEDS

Liber **00003** Page **0176**

Register of Deeds Stamp & File Number

4. Lot No. \_\_\_\_\_, Recorded Plat \_\_\_\_\_  
5. Private Claims \_\_\_\_\_

I, EDWARD W. REED, in a field survey on JULY 18, 1997 do hereby state that under requirements of P.A. 74, Michigan P.A. of 1970, the corner points mentioned in lines 1 and 2 above were in conformance with regulations and rules therefore as required in the current manual of survey instructions of the United States Department of the Interior, Bureau of Land Management or by a decree of a Court of Law and for that the corner points mentioned in lines 3, 4 and 5 above were in conformance with the rules of the Michigan Board of Land Surveyors or by a Decree of a Court of Law; established, re-established, monumented, recovered, found as expressed below:

**NOTE: Not more than 2 corners, all in the same town and range, may be recorded on this certificate.**

	A	B	C	D	E	F	G	H	I	J	K	L	M
1													
2		6		5		4		3		2		1	
3													
4		7		8		9		10		11		12	
5													
6		18		17		16		15		14		13	
7													
8		19		20		21		22		23		24	
9													
10		30		29		28		27		26		25	
11													
12		31		32		33		34		35		36	
13													

A. Description of original monument and accessories and/or subsequent restoration:  
CORNER COMMON TO SECTIONS 21-22-27-28

- 1825: WM BROOKFIELD, DEPT SURVEYOR - SET CORNER
- 1910: WW COX, DEPT SURVEYOR - FOUND OLD RED CEDAR STAKE IN STONES & BRICK, PLANTED 1" IRON ROD 24" LONG BESIDE STAKE.
- 1963: E.R. REED, CO SURVEYOR, SURVEY TIED TO CORNER, (STEEL PIN)
- 1971: E.R. REED, CO SURVEYOR, SURVEY TIED TO CORNER (IRON ROD)
- 1997: E.W. REED, SURVEYOR - FOUND 1" SQUARE HEADED BOLT IN CI-MONUMENT BOX, UNABLE TO REMOVE IRON, DROVE 1/2" X 18" REBAR IRON AT ANGLE OVER OLD IRON, RAISED CI- BOX TO ROAD SURFACE WITH RINGS RECORDED IN LCRC # III-127

B. Description of corner evidence found and/or method applied in restoring or reestablishing corner:

FOUND 1/2" IRON ROD IN CI-MONUMENT BOX AS DESCRIBED IN LCRC # III-127

C. Description of monument for corner and accessories established to perpetuate locating the position of the corner:

1/2" IRON ROD WITH REMON CAP IN CI-MONUMENT BOX FLUSH WITH ROAD SURFACE

- TEL. PED N35E 65.6 TO SW CORNER
- TEL. PED, S20E 80.0
- SE CORNER OF BASE OF ORNAMENTAL LIGHT POST, N60W 58.5'
- GTE PED., N25W 70.9' TO SE CORNER
- SE CORNER OF HOUSE #300, S79W 64.95'
- 38" BEECH, N60W 40.4' TO CENTER

ACCEPTED BY THE BRANCH COUNTY  
SURVEY PEER GROUP AS THE OFFICIAL  
CORNER UNDER MICHIGAN PUBLIC ACT 345  
OF 1990 AT A MEETING HELD ON  
9-10-97


*E.R. Reed, Co. Rep.*  
**E.R. REED**

AND IS ACCEPTED AS A CAREFUL AND FAITHFUL PERPETUATION OF THE POSITION OF THE ORIGINAL CORNER

Signed by *Edward W. Reed*  
EDWARD W. REED

Date MAY 2, 1997

Surveyor's Michigan License No. 33985

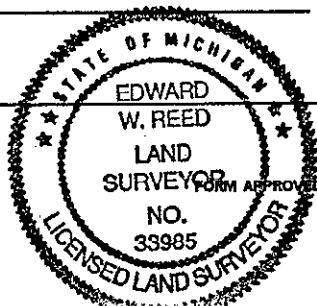

FORM APPROVED BY MICHIGAN STATE BOARD OF PROFESSIONAL SURVEYORS, JAN. 28  
REVISED MAY 14, 1975

REVISED JAN., 198  
REVISED OCT., 199