

SURVEY & REMONUMENTATION

MAR 13 1998

SECTION

BRANCH COUNTY REMONUMENTATION CORNER LAND CORNER RECORDATION CERTIFICATE Filing Requirement of Act 74, Mich. P.A. 1970

For corners in

Form with fields for BRANCH (County), Located in, and Corner Code #. Includes options for Public Land Survey, Property Controlling in Section, and Miscellaneous Property in Sec.

STATE OF MICHIGAN Branch County Recorded

10-22-1997 09:57:42

Linda Lee Morrison-Mathews REGISTER OF DEEDS

Liber 00003 Page 0173

Register of Deeds Stamp & File Number

4. Lot No. , Recorded Plat
5. Private Claims

I, EDWARD W. REED, in a field survey on SEPTEMBER 3, 1997 do hereby state that under requirements of P.A. 74, Michigan P.A. of 1970, the corner points mentioned in lines 1 and 2 above were in conformance with regulations and rules therefore as required in the current manual of survey instructions of the United States Department of the Interior, Bureau of Land Management or by a decree of a Court of Law and /or that the corner points mentioned in lines 3, 4 and 5 above were in conformance with the rules of the Michigan Board of Land Surveyors or by a Decree of a Court of Law; established, re-established, monumented, recovered, found as expressed below:

NOTE: Not more than 2 corners, all in the same town and range, may be recorded on this certificate.

Grid table with columns A-M and rows 1-13. A dot is marked at the intersection of column G and row 11.

A. Description of original monument and accessories and/or subsequent restoration: 1825: WM BROOKFIELD, DEPT. SURVEYOR - CORNER SET 1923: E.L. MINER, CO SURVEYOR - FOUND STONE 1976: E.R REED, CO. SURVEYOR - CORNER OBLITERATED BY ROAD CONSTRUCTION, RESET CORNER BY RETRACTION SURVEY OF MINERS 1923 FIELD NOTES, SET 3/4" SOLID IRON ROD, RECORDED LCRC # 184

B. Description of corner evidence found and/or method applied in restoring or reestablishing corner: FOUND 3/4" IRON ROD AS DESCRIBED IN LCRC # 184

C. Description of monument for corner and accessories established to perpetuate locating the position of the corner: SET 1/2" X 18" REBAR IRON WITH REMON CAP IN CI-MONUMENT BOX FLUSH WITH ROAD SURFACE

SW CORNER SCHOOL HOUSE (NOW HOME) S39E 136.6' POWER POLE, S51W 71.2' TO FACE SE CORNER BUILDING, N52W 159.8' 36" MAPLE, S51E 46.6' TO CENTER POWER POLE, N32E 78.2' TO FACE

ACCEPTED BY THE BRANCH COUNTY SURVEY PEER GROUP AS THE OFFICIAL CORNER UNDER MICHIGAN PUBLIC ACT 345 OF 1990 AT A MEETING HELD ON 9-10-97


E. Reed Co. Rep. E. REED, P.S.

AND IS ACCEPTED AS A CAREFUL AND FAITHFUL PERPETUATION OF THE POSITION OF THE ORIGINAL CORNER

Signed by Edward W. Reed EDWARD W. REED

Date SEPTEMBER 3, 1997

Surveyor's Michigan License No. 33985

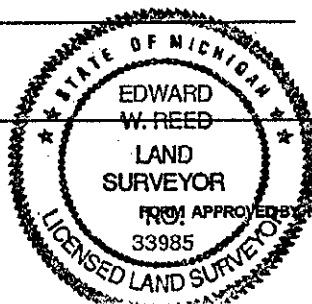

FROM APPROVED BY MICHIGAN STATE BOARD OF PROFESSIONAL SURVEYORS, JAN. 28 33985 REVISED MAY 14, 1975

REVISED JAN., 198 REVISED OCT., 199