

SURVEY & REMONUMENTATION

FEB 08 1999

SECTION

**BRANCH COUNTY REMONUMENTATION PROGRAM
LAND CORNER RECORDATION CERTIFICATE
Filing Requirement of Act 74, Mich. P.A. 1970**

For corners in

<u>BRANCH COUNTY</u> QUINCY TWP	Located In:	Corner Code #
1. Public Land Survey	<u>T 6 S R 5 W</u>	<u>G-13</u>
	T _____ R _____	_____
	T _____ R _____	_____
	T _____ R _____	_____
2. Property Controlling in Section	S _____ T _____ R _____	_____
	S _____	_____
	T _____ R _____	_____
3. Miscellaneous	S _____	_____
	T _____ R _____	_____
Property in Sec.	S _____	_____
	T _____ R _____	_____

STATE OF MICHIGAN
Branch County
Recorded

12-07-1998 13:54:14

Linda Lee Morrison-Mathews
REGISTER OF DEEDS

Liber **00003** Page **0254**

Register of Deeds Stamp & File Number

ACCEPTED BY THE BRANCH COUNTY SURVEY PEER GROUP AS THE OFFICIAL CORNER UNDER MICHIGAN PUBLIC ACT 345 OF 1990 AT A MEETING HELD ON

11-04-1998

E.R. Reed Co. Rep.
E.R. REED

4. Lot No. _____, Recorded Plat _____

5. Private Claims _____

I, EDWARD W. REED, in a field survey on AUGUST 18, 19 98 do hereby state that under requirements of P.A. 74, Michigan P.A. of 1970, the corner points mentioned in lines 1 and 2 above were in conformance with regulations and rules therefore as required in the current manual of survey instructions of the United States Department of the Interior, Bureau of Land Management or by a decree of a Court of Law and /or that the corner points mentioned in lines 3, 4 and 5 above were in conformance with the rules of the Michigan Board of Land Surveyors or by a Decree of a Court of Law; established, re-established, monumented, recovered, found as expressed below:

NOTE: Not more than 2 corners, all in the same town and range, may be recorded on this certificate.

SOUTHEAST CORNER SECTION 33
SOUTHWEST CORNER SECTION 34

	A	B	C	D	E	F	G	H	I	J	K	L	M
1													
2		6		5		4		3		2		1	
3													
4		7		8		9		10		11		12	
5													
6		18		17		16		15		14		13	
7													
8		19		20		21		22		23		24	
9													
10		30		29		28		27		26		25	
11													
12		31		32		33		34		35		36	
13													

A. Description of original monument and accessories and/or subsequent restoration:

1825: JOHN MULLET, DEPT SURVEYOR., CORNER SET
GLO OFFSET 65 LINKS EAST OF ALGANSEE CORNER


B. Description of corner evidence found and/or method applied in restoring or reestablishing corner:

UNABLE TO LOCATE ANY EVIDENCE OF CORNER
RESET CORNER FROM GLO OFFSET, ON LINE WITH CORNERS EAST & WEST

C. Description of monument for corner and accessories established to perpetuate locating the position of the corner:

SET 1/2" X 18" REBAR IRON ROD WITH REMON CAP IN CI-MONUMENT BOX FLUSH WITH PAVED ROAD SURFACE

SOUTH END ROAD CULVERT	S 05 E	22.65'
NORTH END ROAD CULVERT	N 40 E	20.2'
SW CORNER TEL PED	N 40 E	32.33'
NE CORNER TEL PED	S 05 E	93.50'
ALGANSEE CORNER	WEST	42.90'

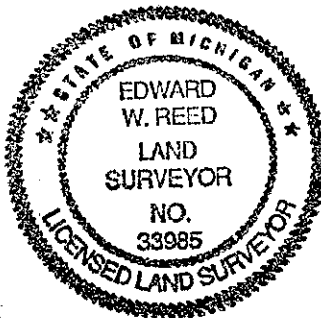

AND IS ACCEPTED AS THE BEST AVAILABLE EVIDENCE OF THE POSITION OF THE ORIGINAL CORNER.

Signed by Edward W. Reed

Date NOV. 4, 1998

EDWARD W, REED

Surveyor's Michigan License No. 33985