

SURVEY & REMONUMENTATION

FEB 08 1999

SECTION

**BRANCH COUNTY REMONUMENTATION PROGRAM
LAND CORNER RECORDATION CERTIFICATE
Filing Requirement of Act 74, Mich. P.A. 1970**

For corners in

<u>BRANCH COUNTY</u> QUINCY TWP	Located In:	Corner Code #
1. Public Land Survey	T <u>6</u> S R <u>5</u> W	<u>H-13</u>
	T _____ R _____	_____
	T _____ R _____	_____
	T _____ R _____	_____
2. Property Controlling	S _____ T _____ R _____	_____
in Section	S _____	_____
	T _____ R _____	_____
3. Miscellaneous	S _____	_____
	T _____ R _____	_____
Property in Sec.	S _____	_____
	T _____ R _____	_____

STATE OF MICHIGAN
Branch County
Recorded

11-04-1998 15:47:14

Linda Lee Morrison-Mathews
REGISTER OF DEEDS

Register of Deeds Stamp & File Number

ACCEPTED BY THE BRANCH COUNTY
SURVEY PEER GROUP AS THE OFFICIAL
CORNER UNDER MICHIGAN PUBLIC ACT 345
OF 1990 AT A MEETING HELD ON

9-09-98

E.R. Reed Co. Rep.

E.R. REED

4. Lot No. _____, Recorded Plat _____
5. Private Claims _____

I, EDWARD W. REED, in a field survey on JULY 14, 1998 do hereby state that under requirements of P.A. 74, Michigan P.A. of 1970, the corner points mentioned in lines 1 and 2 above were in conformance with regulations and rules therefore as required in the current manual of survey instructions of the United States Department of the Interior, Bureau of Land Management or by a decree of a Court of Law and /or that the corner points mentioned in lines 3, 4 and 5 above were in conformance with the rules of the Michigan Board of Land Surveyors or by a Decree of a Court of Law; established, re-established, monumented, recovered, found as expressed below:

NOTE: Not more than 2 corners, all in the same town and range, may be recorded on this certificate.

SOUTH QUARTER CORNER SECTION 34, QUINCY TWP

A. Description of original monument and accessories and/or subsequent restoration:

1825: J. MULLET, D.S. - CORNER SET

1875: M. KNOLWES, DEPT. CO SURVEYOR - FOUND CEDAR STAKE, PUT BRICK & STONE ABOVE THE STAKE

B. Description of corner evidence found and/or method applied in restoring or reestablishing corner:

DUG LARGE HOLE WITH BACKHOE, FOUND NOTHING REMAINING FOR CORNER
RESET ON LINE AND MIDWAY BETWEEN CORNERS EAST AND WEST

C. Description of monument for corner and accessories established to perpetuate locating the position of the corner:

SET 1/2" X 18" REBAR IRON WITH REMON CAP IN CI-MONUMENT BOX 4" BELOW GRAVEL ROAD SURFACE


TEL PED	N 38 E	32.4' TO FACE
TEL PED	N 55 W	67.5' TO FACE
36" MAPLE	S 55W	73.5' TO CENTER
TEL PED	SOUTH	93.4' TO FACE
SW COR. GARAGE	N 50 E	113.45

AND IS ACCEPTED AS A CAREFUL AND FAITHFUL REESTABLISHMENT OF THE POSITION OF THE ORIGINAL CORNER.

Signed by *Edward W. Reed*

EDWARD W, REED

Surveyor's Michigan License No. 33985

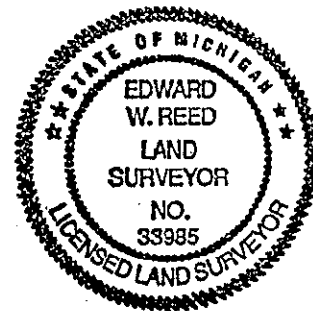

Date 9-9-98

Liber 00003 Page 0220

FORM APPROVED BY MICHIGAN STATE BOARD OF PROFESSIONALS