

RF

FEB 11 2000

SECTION

BRANCH COUNTY REMONUMATION PROGRAM
LAND CORNER RECORDATION CERTIFICATE
 Filing Requirement of Act 74, Mich. P.A. 1970

STATE OF MICHIGAN
 Branch County
 Recorded

11-03-1999 15:14:07

Linda Lee Morrison-Mathews
 REGISTER OF DEEDS

Liber **00004** Page **0028**

Register of Deeds Stamp & File Number

For corners in

<u>BRANCH COUNTY</u>	Located In:	Corner Code #
COLDWATER TWP		
1. Public Land Survey	<u>T 6 S R 6 W</u>	<u>A-11</u>
	T ___ R ___	_____
	T ___ R ___	_____
	T ___ R ___	_____
2. Property Controlling in Section	S ___ T ___ R ___	_____
	S ___	_____
	T ___ R ___	_____
3. Miscellaneous	S ___	_____
	T ___ R ___	_____
Property in Sec.	S ___	_____
	T ___ R ___	_____

4. Lot No. _____, Recorded Plat _____

5. Private Claims _____

I, EDWARD W. REED, in a field survey on JULY 6, 19 99 do hereby state that under requirements of P.A. 74, Michigan P.A. of 1970, the corner points mentioned in lines 1 and 2 above were in conformance with regulations and rules therefore as required in the current manual of survey instructions of the United States Department of the Interior, Bureau of Land Management or by a decree of a Court of Law and /or that the corner points mentioned in lines 3, 4 and 5 above were in conformance with the rules of the Michigan Board of Land Surveyors or by a Decree of a Court of Law; established, re-established, monumented, recovered, found as expressed below:

NOTE: Not more than 2 corners, all in the same town and range, may be recorded on this certificate.

CORNER COMMON TO SECTIONS 25 & 36 BATAVIA TWP &
 SECTIONS 30 & 31 COLDWATER TWP.

	A	B	C	D	E	F	G	H	I	J	K	L	M
1													
2	6		5		4		3		2		1		
3													
4	7		8		9		10		11		12		
5													
6	16		17		18		19		20		21		22
7													
8	19		20		21		22		23		24		
9													
10	30		29		28		27		26		25		
11													
12	31		32		33		34		35		36		
13													

A. Description of original monument and accessories and/or subsequent restoration:

1825: JOHN MULLET, CORNER SET FOR BATAVIA
 1825: WM BROOKFIELD, CORNER SET FOR COLDWATER

B. Description of corner evidence found and/or method applied in restoring or reestablishing corner:


FOUND 3/4" X 18" SOLID IRON IN LINE WITH FENCE LINES RUNNING NORTH & SOUTH, ALSO IN C/L ROAD EAST & WEST
 FOUND NOTHING BELOW OR AROUND IRON
 SET 1/2" X 18" REBAR IRON WITH REMON CAP IN CAST IRON MONUMENT BOX

C. Description of monument for corner and accessories established to perpetuate locating the position of the corner:

1/2" X 18" REBAR IRON WITH REMON CAP IN CAST IRON MONUMENT BOX FLUSH WITH PAVED ROAD SURFACE
 SOUTH 24.65' FACE 2' CONCRETE POST
 NORTH 22.22' FACE RD WOOD POST
 NORTH 31.1' CENTER OF MULTIPLE MAPLE
 S 38 E 100.6' CENTER 8" BIRCH
 IN CENTERLINE EAST-WEST PAVED ROAD

AND IS ACCEPTED AS THE BEST AVAILABLE EVIDENCE OF THE POSITION OF THE ORIGINAL CORNER.

ACCEPTED BY THE BRANCH COUNTY SURVEY P.E.R. GROUP AS THE OFFICIAL CORNER UNDER MICHIGAN PUBLIC ACT 345 ON 8-2-1999 AT A MEETING HELD ON 7-6-99
 E. R. REED
 E. R. REED Co. Rep.

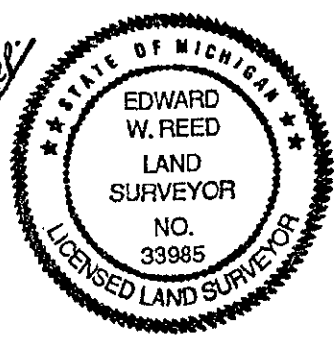

Signed by Edward W. Reed
 EDWARD W. REED

Date JULY 6, 1999

Surveyor's Michigan License No. 33985