

SURVEY & REMONUMENTATION

ACCEPTED BY THE BRANCH COUNTY SURVEY PEER GROUP AS THE OFFICIAL CORNER UNDER MICHIGAN PUBLIC ACT 345 OF 1990 AT A MEETING HELD ON 12-16-98

E. Reed Co. Rep.

APR 26 1995

BRANCH COUNTY REMONUMENTATION CORNER

LAND CORNER RECORDATION CERTIFICATE

Filing Requirement of Act 74, Mich. P.A. 1970

STATE OF MICHIGAN
Branch County

Recorded

12-28-1994 15:04:05

For corners in


Branch _____ <small>(County)</small>	Located In:	Corner Code =#	
1. Public Land Survey	T <u>6</u> S R <u>6</u> W	<u>B-9</u>	
	T _____ R _____	_____	
	T _____ R _____	_____	
	T _____ R _____	_____	
2. Property Controlling in Section	S _____ T _____ R _____	_____	
	S _____ T _____ R _____	_____	
3. Miscellaneous Property in Sec.	S _____ T _____ R _____	_____	
	S _____ T _____ R _____	_____	

Linda Lee Morrison-Mathews
REGISTER OF DEEDS
STATE OF MICHIGAN
BRANCH COUNTY
12-28-1994 15:03:02
Linda Lee Morrison-Mathews
REGISTER OF DEEDS

Liber 00002 Page 0311
Register of Deeds Stamp & File Number

4. Lot No. _____, Recorded Plat _____
5. Private Claims _____

I, Edward W. Reed, in a field survey on September 7, 19 94, do hereby certify that under requirements of P.A. 74, Michigan P.A. of 1970, the corner points mentioned in lines 1 and 2 above were in conformance with regulations and rules theretofore as required in the current manual of survey instructions of the United States Department of the Interior, Bureau of Land Management or by a decree of a Court of Law and/or that the corner points mentioned in lines 3, 4 and 5 above were in conformance with the rules of the Michigan Board of Land Surveyors or by a Decree of a Court of Law; established, re-established, monumented, re-monumented, recovered, found as expressed below:

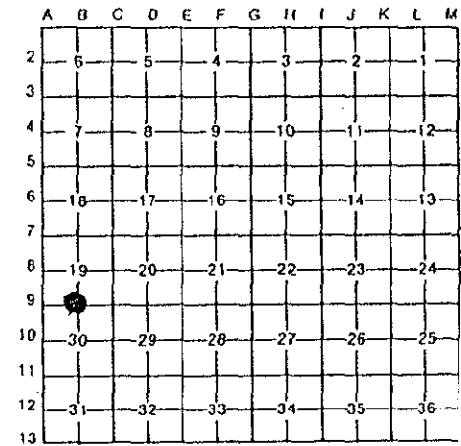


NOTE: Not more than 4 corners, all in the same town and range, may be recorded on this certificate.

A. Description of original monument and accessories and/or subsequent restoration:
 Quarter corner common to Sections 19 and 30, Town 6 South, Range 6 West, Coldwater Township, Branch County, Michigan.
 1825: GLO notes, corner set
 1874: _____ found stake, brick and stone
 1971: E. R. Reed, corner destroyed by road construction, corner restored proportionate distance method, set 3/4" steel pin, recorded #13
 1972: E. R. Reed, found 3/4" steel pin, recorded #40
 1977: E. R. Reed, iron found
 1990: E. W. Reed, iron found

B. Description of corner evidence found and/or method applied in restoring or reestablishing corner:
 Found 5/8" x 12" rebar
 Removed 5/8" rebar and set 1/2" x 18" rebar, cast iron monument box and remonumentation cap

C. Description of monument for corner and accessories established to perpetuate locating the position of the corner:
 1/2" rebar as noted above:
 South 32 East 31.5'-to face of telephone pole
 South 67 West 80.5'-to center of 30" maple
 North 22° East 112'-to face of telephone pole
 East 16.92'-to iron rod

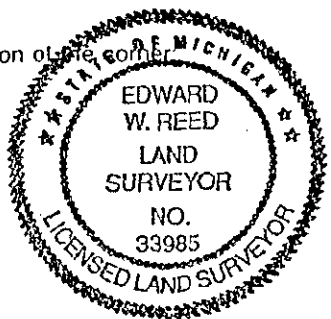

And is accepted as a careful and faithful perpetuation of the position of the original corner.

Signed by Edward W. Reed Date September 7, 1994
 Surveyor's Michigan License No. 33985