

# SURVEY & REMONUMENTATION

ACCEPTED BY THE BRANCH COUNTY SURVEY PEER GROUP AS THE OFFICIAL CORNER UNDER MICHIGAN PUBLIC ACT 345 OF 1980 AT A MEETING HELD ON 12-16-94

APR 26 1995

BRANCH COUNTY REMONUMENTATION CORNER

LAND CORNER RECORDATION CERTIFICATE

Filing Requirement of Act 74, Mich. P.A. 1970

E. Reed, C. Rep.

For corners in

Branch (County)	Located In:	Corner Code ##
1. Public Land Survey	T <u>6</u> S R <u>6</u> W	<u>C-1</u>
	T _____ R _____	_____
	T _____ R _____	_____
	T _____ R _____	_____
2. Property Controlling in Section	S _____ T _____ R _____	_____
	S _____ T _____ R _____	_____
3. Miscellaneous Property in Sec.	S _____ T _____ R _____	_____
	S _____ T _____ R _____	_____

STATE OF MICHIGAN  
Branch County  
Recorded

12-28-1994 15:04:15

Linda Lee Morrison-Mathews  
REGISTERED DEEDS Page **0312**

Register of Deeds Stamp & File Number

4. Lot No. \_\_\_\_\_, Recorded Plat \_\_\_\_\_  
5. Private Claims \_\_\_\_\_

	A	B	C	D	E	F	G	H	I	J	K	L	M
2	6		5		4		3		2		1		
3													
4	7		8		9		10		11		12		
5													
6	18		17		16		15		14		13		
7													
8	19		20		21		22		23		24		
9													
10	30		29		28		27		26		25		
11													
12	31		32		33		34		35		36		
13													

I, Edward W. Reed, in a field survey on September 23, 19 94, do hereby certify that under requirements of P.A. 74, Michigan P.A. of 1970, the corner points mentioned in lines 1 and 2 above were in conformance with regulations and rules therefore as required in the current manual of survey instructions of the United States Department of the Interior, Bureau of Land Management or by a decree of a Court of Law and/or that the corner points mentioned in lines 3, 4 and 5 above were in conformance with the rules of the Michigan Board of Land Surveyors or by a Decree of a Court of Law; established, re-established, monumented, re-monumented, recovered, found as expressed below:

NOTE: Not more than 4 corners, all in the same town and range, may be recorded on this certificate.

**A. Description of original monument and accessories and/or subsequent restoration:**


Northeast corner, Section 6 and Northwest corner, Section 5, Town 6 South, Range 6 West, Coldwater Township, Branch County, Michigan.  
1825: GLO notes, set at 80.65  
1975: Boone, found iron pin, dug below, and found nothing, recorded #166  
1988: E. R. Reed, found iron

**B. Description of corner evidence found and/or method applied in restoring or reestablishing corner:**

Found boat spike set over 1/2" rebar agreeing with old witness, removed & set 1/2" x 18" rebar  
Set remonumentation cap and cast iron monument box flush with road surface

**C. Description of monument for corner and accessories established to perpetuate locating the position of the corner:**

1/2" rebar as noted above:  
North 49 East 45.75'-to center of steel fence post  
South 13 West 26.70'-to center of 2" steel fence post  
South 29.52'-to center of south fence post  
South 2 East 31.1'-to face of telephone pedestal  
East 59.2'-to centerline of North-South roads  
North 44 West 54.18'-to face of power pole

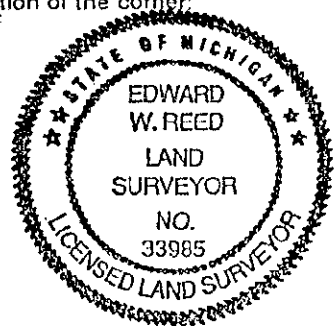

And is accepted as a careful and faithful perpetuation of the position of the original corner.

Signed by Edward W. Reed Date September 23, 1994  
Surveyor's Michigan License No. 33985