

# SURVEY & REMONUMENTATION

APR 26 1995

BRANCH COUNTY REMONUMENTATION CORNER  
LAND SURVEYOR'S COMMISSION CERTIFICATE  
Filing Requirement of Act 74, Mich. P.A. 1970

ACCEPTED BY THE BRANCH COUNTY  
SURVEY PEER GROUP AS THE OFFICIAL  
CORNER UNDER MICHIGAN PUBLIC ACT 345  
OF 1990 AT A MEETING HELD ON  
12-16-94

E. Reed, Co. Rep.

For corners in

Branch _____ <small>(County)</small>	Located In:	Corner Code <u>==</u>
1. Public Land Survey	T <u>6</u> S. R <u>6</u> W.	<u>C-5</u>
	T _____ R _____	_____
	T _____ R _____	_____
	T _____ R _____	_____
2. Property Controlling in Section	S _____ T _____ R _____	_____
	S _____ T _____ R _____	_____
3. Miscellaneous Property in Sec.	S _____ T _____ R _____	_____

STATE OF MICHIGAN  
Branch County  
Recorded  
Liber 000002 Page 0315  
12-28-1994 15:04:42  
  
Linda Lee Morrison-Mathews  
Register of Deeds, Stamp & File Number


4. Lot No. \_\_\_\_\_, Recorded Plat \_\_\_\_\_  
5. Private Claims \_\_\_\_\_

I, Edward W. Reed, in a field survey on September 22, 19 94, do hereby certify that under requirements of P.A. 74, Michigan P.A. of 1970, the corner points mentioned in lines 1 and 2 above were in conformance with regulations and rules therefore as required in the current manual of survey instructions of the United States Department of the Interior, Bureau of Land Management or by a decree of a Court of Law and/or that the corner points mentioned in lines 3, 4 and 5 above were in conformance with the rules of the Michigan Board of Land Surveyors or by a Decree of a Court of Law; established, re-established, monumented, re-monumented, recovered, found as expressed below:


**NOTE: Not more than 4 corners, all in the same town and range, may be recorded on this certificate.**

A. Description of original monument and accessories and/or subsequent restoration:  
Corner common to Sections 7, 8, 17 and 18, Town 6 South, Range 6 West, Coldwater Township, Branch County, Michigan.  
1825: GLO notes, corner set  
1908: Hamilton, corner missing, reset stake  
1959: U.S. Highway Right-of-Way Maps refer to corner  
Plat of "Almary Shores" refer to corner  
1970: M.S. H.D. notes, found 3/4" rerod  
1971: E. R. Reed, found iron rod  
1974: Carr, found 1/2" iron, recorded #101  
1992: E. W. Reed, found iron rod

B. Description of corner evidence found and/or method applied in restoring or reestablishing corner:  
Found 1/2" iron 6" below surface of road agreeing with old witness  
Set remonumentation cap on top of iron  
Set cast iron monumentation box flush with road surface

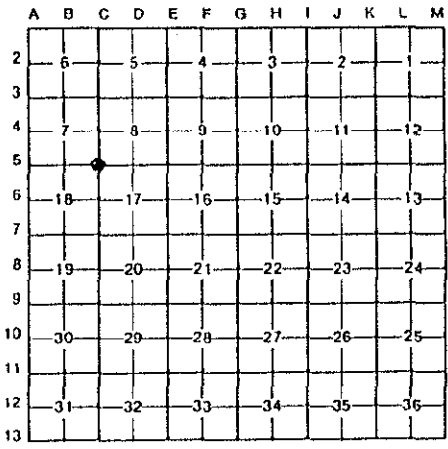

C. Description of monument for corner and accessories established to perpetuate locating the position of the corner:  
1/2" iron as noted above:  
South 40 West 40.38-face of concrete anchor post  
North 40 East 40.65-face of concrete anchor post  
South 40 East 51.06-face of telephone pedestal  
Centerline of North-South road  
1' South of centerline of Hurley Road  
South 25 West 59.00-14" maple  
North 15 West 90.57-17" cedar  
North 33 West 123.74-Southeast corner of house  
North 20 East 118.05-face of power pole

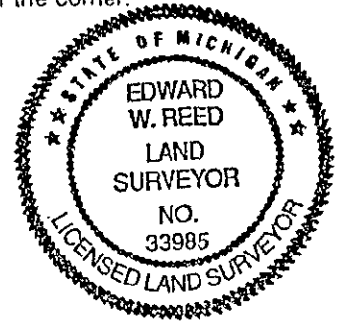

And is accepted as a careful and faithful perpetuation of the position of the original corner.  
Signed by Edward W. Reed Date September 22, 1994  
Surveyor's Michigan License No. 33985