

SURVEY & REMONUMENTATION

ACCEPTED BY THE BRANCH COUNTY SURVEY PEER GROUP AS THE OFFICIAL CORNER UNDER MICHIGAN PUBLIC ACT 345 OF 1990 AT A MEETING HELD ON 12-16-94

APR 26 1995

BRANCH COUNTY REMONUMENTATION CORNER
LAND CORNER RESTORATION CERTIFICATE
Filing Requirement of Act 74, Mich. P.A. 1970

E. Reed, Co. Rep.

For corners in

<u>Branch</u> <small>(County)</small>	Located In:	Corner Code =#	
1. Public Land Survey	T <u>6</u> S R <u>6</u> W	<u>C-9</u>	
	T _____ R _____	_____	
	T _____ R _____	_____	
	T _____ R _____	_____	
2. Property Controlling in Section	S _____ T _____ R _____	_____	
	S _____ T _____ R _____	_____	
3. Miscellaneous Property in Sec.	S _____ T _____ R _____	_____	
	S _____ T _____ R _____	_____	
4. Lot No. _____, Recorded Plat _____			
5. Private Claims _____			

STATE OF MICHIGAN
Branch County
Recorded


12-28-1994 15:04:50

Linda G. Thompson-Mathews
REGISTER OF DEEDS Page 0016

Register of Deeds Stamp & File Number

I, Edward W. Reed, in a field survey on September 7, 19 94, do hereby certify that under requirements of P.A. 74, Michigan P.A. of 1970, the corner points mentioned in lines 1 and 2 above were in conformance with regulations and rules therefore as required in the current manual of survey instructions of the United States Department of the Interior, Bureau of Land Management or by a decree of a Court of Law and/or that the corner points mentioned in lines 3, 4 and 5 above were in conformance with the rules of the Michigan Board of Land Surveyors or by a Decree of a Court of Law; established, re-established, monumented, re-monumented, recovered, found as expressed below:


NOTE: Not more than 4 corners, all in the same town and range, may be recorded on this certificate.

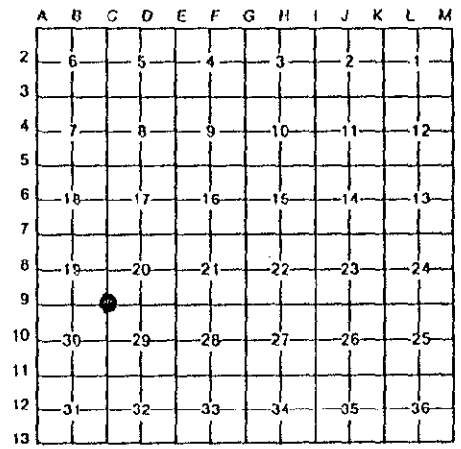

A. Description of original monument and accessories and/or subsequent restoration:
 Corner common to Sections 19, 20, 29 and 30, Town 6 South, Range 6 West, Coldwater Township, Branch County, Michigan.
 1825: GLO notes, corner set
 1867: 1/117 Survey Records, found stone and brick
 1973: E. R. Reed, found stone, brick and 4" stove bolt, set 3/4" iron in cast iron box, recorded #83
 1947: Russell, corner found

B. Description of corner evidence found and/or method applied in restoring or reestablishing corner:
 Found 5/8" x 18" rebar iron
 Set remonumentation cap over rebar iron

C. Description of monument for corner and accessories established to perpetuate locating the position of the corner:
 5/8" rebar as noted above:
 South 39 East 96.6'-northwest corner of house
 South 64 West 120.7'-northeast corner of house
 North 31 East 41.6'-to face of power pole
 South 35 East 50.0'-to face of power pole
 6.0' south of centerline East-West pavement
 North 74° West 175.70'-southeast corner of block garage

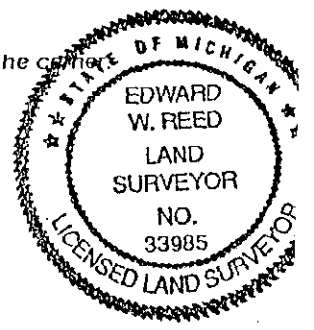

And is accepted as a careful and faithful perpetuation of the position of the original corner.

Signed by Edward W. Reed Date September 7, 1994
 Surveyor's Michigan License No. 33985