

1993

COMMISSION

BRANCH COUNTY REMONUMENTATION CORNER
 LAND CORNER RECORDATION CERTIFICATE
 Filing Requirement of Act 74, Mich. P.A. 1970

For corners in

BRANCH (County)	Located In:	Corner Code #
1. Public Land Survey	T <u>6S</u> R <u>6W</u>	<u>C-10</u>
	T _____ R _____	_____
	T _____ R _____	_____
	T _____ R _____	_____
2. Property Controlling in Section	S _____ T _____ R _____	_____
	S _____ T _____ R _____	_____
3. Miscellaneous Property in Sec.	S _____ T _____ R _____	_____
	S _____ T _____ R _____	_____
4. Lot No. _____, Recorded Plat _____		
5. Private Claims _____		

247

REC'D FOR RECORD
 STATE OF MICHIGAN
 BRANCH COUNTY

93 DEC 27 AM 10:06

REGISTER OF DEEDS

Register of Deeds Stamp & File Number

I, Edward W. Reed, in a field survey on November 22, 1993, do hereby certify that under requirements of P.A. 74, Michigan P.A. of 1970, the corner points mentioned in lines 1 and 2 above were in conformance with regulations and rules therefore as required in the current manual of survey instructions of the United States Department of the Interior, Bureau of Land Management or by a decree of a Court of Law and/or that the corner points mentioned in lines 3, 4 and 5 above were in conformance with the rules of the Michigan Board of Land Surveyors or by a Decree of a Court of Law; established, re-established, monumented, re-monumented, recovered, found as expressed below:

	A	B	C	D	E	F	G	H	I	J	K	L	M
2	6		5		4		3		2		1		
3													
4	7		8		9		10		11		12		
5													
6	18		17		16		15		14		13		
7													
8	19		20		21		22		23		24		
9													
10	30		29		28		27		26		25		
11													
12	31		32		33		34		35		36		
13													

NOTE: Not more than 4 corners, all in the same town and range, may be recorded on this certificate.

A. Description of original monument and accessories and/or subsequent restoration:

QUARTER CORNER, SECTIONS 29 / 30, COLDWATER TOWNSHIP, T6S, R6W

1825: W. Brookfield, GLO Dep. Surveyor
 Set quarter section post. Beech 10", N6½E 20
 Beech 12", S37½E 20


B. Description of corner evidence found and/or method applied in restoring or reestablishing corner:

Witness now gone. Dug hole, unable to locate old post.
 Set ½" x 18" rebar iron with ID cap in monument box on north-south Section line in line with old anchor post and ancient fenceline running west.


C. Description of monument for corner and accessories established to perpetuate locating the position of the corner:

Rebar iron stake as noted above.
 West 29.3' - East face of R.R. rail fence corner post.
 N 20 E 196.1 - Face of Power pole.
 S 20 E 139.4 - Face of Power pole.
 In line with fence running west.

And is accepted as the best available evidence of the position of the original corner

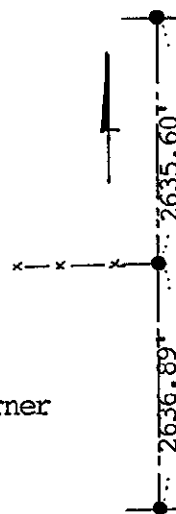

Signed by Edward W. Reed
 Surveyor's Michigan License No. 33985

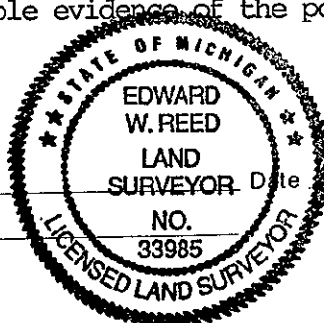

November 22, 1993