

1993

COMMISSION

BRANCH COUNTY REMONUMENTATION CORNER  
LAND CORNER RECORDATION CERTIFICATE  
Filing Requirement of Act 74, Mich. P.A. 1970

For corners in

BRANCH (County)	Located In:	Corner Code #
1. Public Land Survey	T <u>6</u> S R <u>6</u> W	<u>C - 13</u>
	T _____ R _____	_____
	T _____ R _____	_____
	T _____ R _____	_____
2. Property Controlling in Section	S _____ T _____ R _____	_____
	S _____ T _____ R _____	_____
3. Miscellaneous Property in Sec.	S _____ T _____ R _____	_____
	S _____ T _____ R _____	_____

248

REC'D FOR RECORD  
STATE OF MICHIGAN  
BRANCH COUNTY  
93 DEC 27 AM 10:06  
REGISTER OF DEEDS  
*John J. Morrison*

Register of Deeds Stamp & File Number

4. Lot No. \_\_\_\_\_, Recorded Plat \_\_\_\_\_  
5. Private Claims \_\_\_\_\_

I, EDWARD W. REED, in a field survey on DECEMBER 1, 19 93, do hereby certify that under requirements of P.A. 74, Michigan P.A. of 1970, the corner points mentioned in lines 1 and 2 above were in conformance with regulations and rules therefore as required in the current manual of survey instructions of the United States Department of the Interior, Bureau of Land Management or by a decree of a Court of Law and/or that the corner points mentioned in lines 3, 4 and 5 above were in conformance with the rules of the Michigan Board of Land Surveyors or by a Decree of a Court of Law; established, re-established, monumented, re-monumented, recovered, found as expressed below:

NOTE: Not more than 4 corners, all in the same town and range, may be recorded on this certificate.

	A	B	C	D	E	F	G	H	I	J	K	L	M
2	6	5	4	3	2	1							
3													
4	7	8	9	10	11	12							
5													
6	18	17	16	15	14	13							
7													
8	19	20	21	22	23	24							
9													
10	30	29	28	27	26	25							
11													
12	31	32	33	34	35	36							
13													

T6S, R6W

A. Description of original monument and accessories and/or subsequent restoration:

**C-13: SECTION CORNER 31-32 ON SOUTH TOWNSHIP LINE OF T6S, R6W.**

GLO = NOV. 1825 - W. BROOKFIELD, DEP. SURVEYOR: "WEST ON S BOUNDARY SEC. 32. 80.00-SET POST COR SEC'S 31 & 32. BEECH 10 in. N15W 7, BEECH 8 in. N53E 33. \*NOTE THE QR, SEC & SEC CORNER MOVED 128 WEST BY W. BROOKFIELD. SEE BACK OF HIS BOOK OF THE FIELD NOTES OF T6S, R6W."

GLO = 12/16/825 - W. BROOKFIELD, DEP. SURVEYOR: "THE FOLLOWING CORRECTIONS ARE MADE ON THE SOUTH BOUNDARY LINE T6S R6W. ERASED THE POST CORNER OF SEC'S 31 & 32 & MOVED IT 128 LKS TO THE WEST."

SECTION CORNER RECORD CARD FILE = "STONE & 4 BRICKS".

B. Description of corner evidence found and/or method applied in restoring or reestablishing corner:

DUG TO DEPTH OF OVER 3 FEET & STILL IN ROAD GRAVEL. UNABLE TO FIND STONE. IT APPEARS THAT STONE MAY HAVE BEEN REMOVED IN ROAD BUILDING. REESTABLISHED CORNER BY PROTRACTION OF SECTION LINES FROM NORTH, EAST, WEST, AND SOUTH USING OVID TWP. T7S, R6W (SECTION LINE 5-6), AND PRORATION OF GLO OFFSET OF 37 LKS PLUS 128 LKS. SET A 1/2" X 18" REBAR IRON ROD WITH I.D. CAP #33985, IN MONUMENT BOX, AT THIS POINT, AS A CAREFUL AND FAITHFUL REESTABLISHMENT OF THE POSITION OF THE ORIGINAL CORNER.

C. Description of monument for corner and accessories established to perpetuate locating the position of the corner:

**C-13: SECTION CORNER 31-32, ON SOUTH TOWNSHIP LINE, T6S, R6W.**

SET A 1/2" X 18" REBAR IRON ROD WITH I.D. CAP #33985, IN MONUMENT BOX.

S 79 W 127.30' TO NAIL ON N. SIDE 40" MAPLE.


S 65 W 75.10' TO NEAR FACE OF 6" DIA. WOOD CORNER POST.

S 54 E 87.20' TO TOP CENTER OF TELEPHONE PEDESTAL.

EAST 111.50' TO IRON ROD IN MONUMENT BOX, (SECTION CORNER C-1, T7S, R6W, OVID TWP.)

AND IS ACCEPTED AS A CAREFUL AND FAITHFUL REESTABLISHMENT OF THE POSITION OF THE ORIGINAL CORNER.

Signed by *Edward W. Reed*

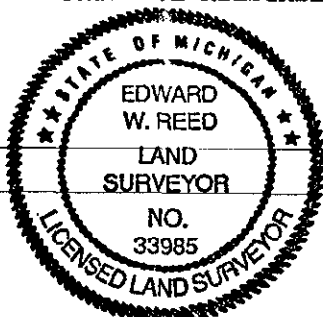

Date 12/01/1993

Surveyor's Michigan License No. 33985