

SURVEY & REMONUMENTATION

ACCEPTED BY THE BRANCH COUNTY
SURVEY PEER GROUP AS THE OFFICIAL
CORNER UNDER MICHIGAN PUBLIC ACT 345
OF 1990 AT A MEETING HELD ON
12-16-94

E. Reed Co. Rep.

APR 26 1995

BRANCH COUNTY REMONUMENTATION CORNER STATE OF MICHIGAN
LAND COMMISSION RECORDATION CERTIFICATE Branch County
Filing Requirement of Act 74, Mich. P.A. 1970 Recorded

For corners in

Branch _____ <small>(County)</small>	Located In:	Corner Code: //
1. Public Land Survey	T <u>6</u> S R <u>6</u> W	<u>D-9</u>
	T _____ R _____	_____
	T _____ R _____	_____
	T _____ R _____	_____
2. Property Controlling	S _____ T _____ R _____	_____
in Section	S _____ T _____ R _____	_____
3. Miscellaneous	S _____ T _____ R _____	_____
Property in Sec.	S _____ T _____ R _____	_____

12-23-1994 15:04:59

Linda Lee Morrison-Mathews
REGISTER OF DEEDS

Liber 00002 Page 0317

Register of Deeds Stamp & File Number

4. Lot No. _____, Recorded Plat _____
5. Private Claims _____

I, Edward W. Reed, in a field survey on September 7, 1994, do hereby certify that under requirements of P.A. 74, Michigan P.A. of 1970, the corner points mentioned in lines 1 and 2 above were in conformance with regulations and rules therofore as required in the current manual of survey instructions of the United States Department of the Interior, Bureau of Land Management or by a decree of a Court of Law and/or that the corner points mentioned in lines 3, 4 and 5 above were in conformance with the rules of the Michigan Board of Land Surveyors or by a Decree of a Court of Law; established, re-established, monumented, re-monumented, recovered, found as expressed below:

NOTE: Not more than 4 corners, all in the same town and range, may be recorded on this certificate.

	A	B	C	D	E	F	G	H	I	J	K	L	M
2	6	5	4	3	2	1							
3													
4	7	8	9	10	11	12							
5													
6	18	17	16	15	14	13							
7													
8	19	20	21	22	23	24							
9													
10	30	29	28	27	26	25							
11													
12	31	32	33	34	35	36							
13													

A. Description of original monument and accessories and/or subsequent restoration:


Quarter corner common to Sections 20 and 29, Town 6 South, Range 6 West, Coldwater Township, Branch County, Michigan
1825: GLO notes, set post section corner, card file indicates stone and brick
1973: E. R. Reed, found stone surrounded by brick and 40d nail over top -set 3/4" iron in monument box over top, recorded #83
1977: E. R. Reed, iron rod in cast iron box
1992: E. W. Reed, iron rods in cast iron box

B. Description of corner evidence found and/or method applied in restoring or reestablishing corner:

Found 5/8" x 18" rebar iron in cast iron monument box
Set remonumentation cap over same

C. Description of monument for corner and accessories established to perpetuate locating the position of the corner:

5/8" rebar as noted above:
South 5 East 39.1-to face of power pole
North 5 East 29.3-to face of power ple
South 50 East 47.7-to face of telephone pole
3' West of power line running South
South 82 West 135.00-telephone pole
North 41 East 139.14'-Southwest corner of garage addition
North 47 West 110.0-to center of 36" maple

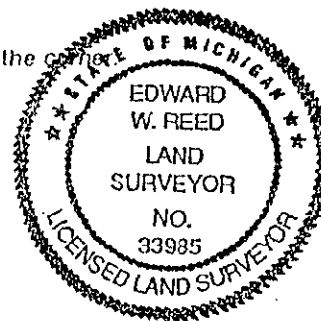

And is accepted as a careful and faithful perpetuation of the position of the original corner.

Signed by Edward W. Reed
Edward W. Reed
Surveyor's Michigan License No. 33985

Date September 7, 1994