

**SURVEY &  
REMONUMENTATION**

E MSC \*009.00

1993

**COMMISSION**

**BRANCH COUNTY REMONUMENTATION CORNER  
LAND CORNER RECORDATION CERTIFICATE**

Filing Requirement of Act 74, Mich. P.A. 1970

For corners in  
**BRANCH**

(County)

Located In:

Corner Code =#

1. Public Land Survey	T <u>6S</u> R <u>6W</u>	<u>F-1</u>
	T _____ R _____	_____
	T _____ R _____	_____
	T _____ R _____	_____
2. Property Controlling in Section	S _____ T _____ R _____	_____
	S _____ T _____ R _____	_____
3. Miscellaneous Property in Sec.	S _____ T _____ R _____	_____
	S _____ T _____ R _____	_____

250

REGISTER OF DEEDS

*John J. Morrison*

93 DEC 27 AM 10:06

REC'D FOR RECORD  
STATE OF MICHIGAN  
BRANCH COUNTY

Register of Deeds Stamp & File Number

4. Lot No. \_\_\_\_\_, Recorded Plat \_\_\_\_\_  
5. Private Claims \_\_\_\_\_

	A	B	C	D	E	F	G	H	I	J	K	L	M
2	6	5	4	3	2	1							
3													
4	7	8	9	10	11	12							
5													
6	18	17	16	15	14	13							
7													
8	19	20	21	22	23	24							
9													
10	30	29	28	27	26	25							
11													
12	31	32	33	34	35	36							
13													

I, Edward W. Reed in a field survey on November 30, 19 93, do hereby certify that under requirements of P.A. 74, Michigan P.A. of 1970, the corner points mentioned in lines 1 and 2 above were in conformance with regulations and rules therefore as required in the current manual of survey instructions of the United States Department of the Interior, Bureau of Land Management or by a decree of a Court of Law and/or that the corner points mentioned in lines 3, 4 and 5 above were in conformance with the rules of the Michigan Board of Land Surveyors or by a Decree of a Court of Law; established, re-established, monumented, re-monumented, recovered, found as expressed below:

**NOTE: Not more than 4 corners, all in the same town and range, may be recorded on this certificate.**

A. Description of original monument and accessories and/or subsequent restoration:

NORTH QUARTER CORNER SECTION 4, T6S, R6W

Old corner records of E.R.Reed, County Surveyor: Iron & stone witness- SW corner house N70E 340 links (224.4')  
SE corner house N60W 250 links

B. Description of corner evidence found and/or method applied in restoring or reestablishing corner:


Dug large hole through 2 foot of fill to old road pavement, then 2 foot below old road pavement, found no trace of iron, stone or wood post.

Reset corner on north section line in line with old fence remains running south, and using old witness of - SW corner house N70E 224.4'.

Set 1/2" x 18" rebar iron with ID cap in CI monument box.

C. Description of monument for corner and accessories established to perpetuate locating the position of the corner:

Rebar iron as noted above.  
N 70 E 224.4', SW corner house  
S 15W 30.5', near face power pole  
S 60 W 111.5', center 12" Maple  
N 63 W 83.1', near face power pole

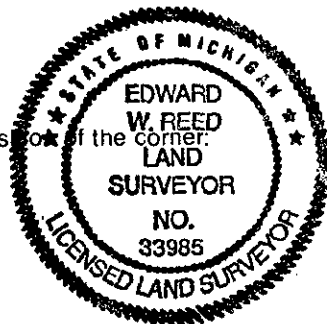

And is accepted as the best available evidence of the position of the original corner.

Signed by *Edward W. Reed*

Date November 30, 1993

Surveyor's Michigan License No. 33985