

SURVEY & REMONUMENTATION

ACCEPTED BY THE BRANCH COUNTY SURVEY PEER GROUP AS THE OFFICIAL CORNER UNDER MICHIGAN PUBLIC ACT 345 OF 1990 AT A MEETING HELD ON 12-16-94

APR 26 1995

BRANCH COUNTY REMONUMENTATION CORNER
LAND COMMISSION
RECORDATION CERTIFICATE
Filing Requirement of Act 74, Mich. P.A. 1970

E. Reed Co. Rep.

For corners in

| | | |
|--|---------------------------|---------------------------|
| <u>Branch</u> <small>(County)</small> | Located In: | Corner Code ## |
| 1. Public Land Survey | T <u>6</u> S R <u>6</u> W | <u>F-9</u> |
| | T _____ R _____ | _____ |
| | T _____ R _____ | _____ |
| | T _____ R _____ | _____ |
| 2. Property Controlling in Section | S _____ T _____ R _____ | _____ |
| | S _____ T _____ R _____ | _____ |
| 3. Miscellaneous Property in Sec. | S _____ T _____ R _____ | _____ |
| | S _____ T _____ R _____ | _____ |
| 4. Lot No. _____, Recorded Plat _____ | | |
| 5. Private Claims _____ | | |

STATE OF MICHIGAN
Branch County
Recorded

12-28-1994 15:05:25

Liber 00002 Page 0320
Linda Lee Morrison-Matthews
REGISTER OF DEEDS

Register of Deeds Stamp & File Number

| | | | | | | | | | | | | | |
|----|----|---|----|---|----|---|----|---|----|---|----|---|---|
| | A | B | C | D | E | F | G | H | I | J | K | L | M |
| 2 | 6 | | 5 | | 4 | | 3 | | 2 | | | | |
| 3 | | | | | | | | | | | | | |
| 4 | 7 | | 8 | | 9 | | 10 | | 11 | | 12 | | |
| 5 | | | | | | | | | | | | | |
| 6 | 10 | | 17 | | 16 | | 15 | | 14 | | 13 | | |
| 7 | | | | | | | | | | | | | |
| 8 | 19 | | 20 | | 21 | | 22 | | 23 | | 24 | | |
| 9 | | | | | ● | | | | | | | | |
| 10 | 30 | | 29 | | 28 | | 27 | | 26 | | 25 | | |
| 11 | | | | | | | | | | | | | |
| 12 | 31 | | 32 | | 33 | | 34 | | 35 | | 36 | | |
| 13 | | | | | | | | | | | | | |

I, Edward W. Reed, in a field survey on September 7, 19 94, do hereby certify that under requirements of P.A. 74, Michigan P.A. of 1970, the corner points mentioned in lines 1 and 2 above were in conformance with regulations and rules therefore as required in the current manual of survey instructions of the United States Department of the Interior, Bureau of Land Management or by a decree of a Court of Law and/or that the corner points mentioned in lines 3, 4 and 5 above were in conformance with the rules of the Michigan Board of Land Surveyors or by a Decree of a Court of Law; established, re-established, monumented, re-monumented, recovered, found as expressed below:

NOTE: Not more than 4 corners, all in the same town and range, may be recorded on this certificate.

A. Description of original monument and accessories and/or subsequent restoration:


- Quarter corner common to Sections 21 and 28, Town 6 South, Range 6 West, Coldwater Township, Branch County, Michigan.
- 1829: Brookfield GLO notes, set post
4/40 County Surveyors Record, E. L. Miner, found rock in brick
- 1939: Terrill, found stone and broken brick
- 1972: E. R. Reed, found Iron rod over stone, recorded #36
- 1975: E. R. Reed, iron rod over stone in cast iron box

B. Description of corner evidence found and/or method applied in restoring or reestablishing corner:

- Found 5/8" x 9" iron rod in cast iron box.
- Removed and set 1/2" x 18" rebar and remonumentation cap in cast iron box.

C. Description of monument for corner and accessories established to perpetuate locating the position of the corner:

- 1/2" rebar as noted above:
- North 18 East 37.0-to face of power pole
- South 74 East 94.0-to face of power pole
- North 46 East 58.4-to face of 12" hickory
- South 41 West 39.75-to face of power pole
- South 27 West 126.03'-northeast corner of house
- North 68 West 107.71-to face of power pole

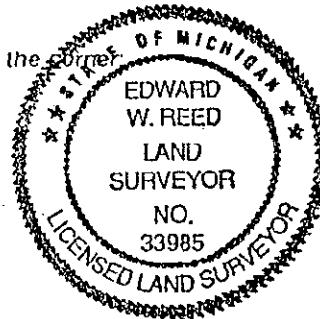

And is accepted as a careful and faithful perpetuation of the position of the original corner.

Signed by Edward W. Reed Date September 7, 1994
Surveyor's Michigan License No. 33985