RE

FEB 2000

SECTION

STATE OF MICHIGAN
Branch County
Recorded

12-30-1999 11:02:33

Linda Lee Morrison-Mathews
REGISTER OF DEEDS

Liber 00004 Page 0061

Register of Deeds Stamp & File Number

BRANCH COUNTY REMONUMENTATION PROGRAM
LAND CORNER RECORDATION CERTIFICATE
Filing Requirement of Act 74, Mich. P.A. 1970

For corners in

BRANCH COUNTY — Located In: COLDWATER TWP — Corner Code #

1. Public Land Survey — T 6 S R 6 W — G-2
   T____ R____
   T____ R____
   T____ R____
2. Property Controlling — S____ T____ R____
   in Section — S____ T____ R____
3. Miscellaneous — S____ T____ R____
   Property in Sec. — S____ T____ R____

ACCEPTED BY THE BRANCH COUNTY SURVEY PEER GROUP AS THE OFFICIAL CORNER UNDER MICHIGAN PUBLIC ACT 345 OF 1990 AT A MEETING HELD ON Dec. 07, 1999.

E.R. Reed, P.S.
E.R. REED

4. Lot No. _____, Recorded Plat _____

5. Private Claims _____

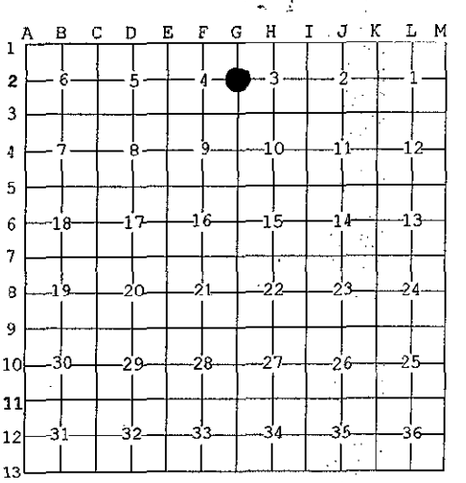

I, EDWARD W. REED, in a field survey on OCT 20, 19 99 do hereby state that under requirements of P.A. 74, Michigan P.A. of 1970, the corner points mentioned in lines 1 and 2 above were in conformance with regulations and rules therefore as required in the current manual of survey instructions of the United States Department of the Interior, Bureau of Land Management or by a decree of a Court of Law and /or that the corner points mentioned in lines 3, 4 and 5 above were in conformance with the rules of the Michigan Board of Land Surveyors or by a Decree of a Court of Law; established, re-established, monumented, recovered, found as expressed below:

NOTE: Not more than 2 corners, all in the same town and range, may be recorded on this certificate.

QUARTER COMMON TO SECTION 3 & 4

A. Description of original monument and accessories and/or subsequent restoration:
1829: ORANGE RISDON-CORNER SET
1856: H. CARY-ESTABLISHED CORNER
1882: M. KNOWLES-SURVEY
STATE HIGHWAY PLANS OF US-27, NO WITNESS OR MENTION OF MONUMENT

B. Description of corner evidence found and/or method applied in restoring or reestablishing corner:
DURING ROAD RECONSTRUCTION THE ASPHALT WAS REMOVED DOWN TO ORIGINAL CONCRETE ROAD
NO CORNER LOCATED
SET POINT ON NORTH-SOUTH SECTION LINE @ GLO CALLS OF 40 CHAINS SOUTH & 41.30 CHAINS NORTH (FITTING ANCIENT FENCELINE WEST)
SET ½" X 10" REBAR IRON WITH REMON CAP IN CAST IRON MONUMENT BOX FLUSH WITH PAVED ROAD SURFACE

C. Description of monument for corner and accessories established to perpetuate locating the position of the corner:
½" X 10" REBAR IRON WITH REMON CAP IN CAST IRON MONUMENT BOX FLUSH WITH PAVED ROAD SURFACE
IN LINE WITH OLD FENCE WEST

SPIKE EAST SIDE OF POWER POLE	S49W 68.06'
SPIKE EAST SIDE OF POWER POLE	N13W 156.65'
TELEPHONE PEDESTAL	S 30 W 110.13'
CENTERLINE NORTH-SOUTH ROAD WEST	
TELEPHONE PEDESTAL	N12W 176.98'
TAG NORTH SIDE 8" BOX ELDER	S61E 65.40'

STATE OF MICHIGAN
EDWARD W. REED
LAND SURVEYOR
NO. 33985
LICENSED LAND SURVEYOR

AND IS ACCEPTED AS A CAREFUL AND FAITHFUL REESTABLISHMENT OF THE POSITION OF THE ORIGINAL CORNER.

Signed by Edward W. Reed — Date Oct. 20, 1999.

EDWARD W. REED

Surveyor's Michigan License No. 33985

FORM APPROVED BY MICHIGAN STATE BOARD OF PROFESSIONAL SURVEYORS, JAN. 28, 1971
REVISED MAY 14,1975
REVISED JAN., 1983
REVISED OCT., 1995