

1993

BRANCH COUNTY REMONUMENTATION CORNER

COMMISSION

LAND CORNER RECORDATION CERTIFICATE

Filing Requirement of Act 74, Mich. P.A. 1970

For corners in

BRANCH (County)	Located In:	Corner Code #
1. Public Land Survey	T <u>6S</u> R <u>6W</u>	<u>H 1</u>
	T _____ R _____	_____
	T _____ R _____	_____
	T _____ R _____	_____
2. Property Controlling in Section	S _____ T _____ R _____	_____
	S _____ T _____ R _____	_____
3. Miscellaneous Property in Sec.	S _____ T _____ R _____	_____
	S _____ T _____ R _____	_____

REC'D FOR RECORD
STATE OF MICHIGAN
BRANCH COUNTY

93 DEC 27 AM 10:06

REGISTER OF DEEDS

252

Register of Deeds Stamp & File Number

- 4. Lot No. _____, Recorded Plat _____
- 5. Private Claims _____

	A	B	C	D	E	F	G	H	I	J	K	L	M
2	6	5	4	3	2	1							
3													
4	7	8	9	10	11	12							
5													
6	18	17	16	15	14	13							
7													
8	19	20	21	22	23	24							
9													
10	30	29	28	27	26	25							
11													
12	31	32	33	34	35	36							
13													

I, Edward W. Reed in a field survey on November 30, 19 93, do hereby certify that under requirements of P.A. 74, Michigan P.A. of 1970, the corner points mentioned in lines 1 and 2 above were in conformance with regulations and rules therefore as required in the current manual of survey instructions of the United States Department of the Interior, Bureau of Land Management or by a decree of a Court of Law and/or that the corner points mentioned in lines 3, 4 and 5 above were in conformance with the rules of the Michigan Board of Land Surveyors or by a Decree of a Court of Law; established, re-established, monumented, re-monumented, recovered, found as expressed below:

NOTE: Not more than 4 corners, all in the same town and range, may be recorded on this certificate.

A. Description of original monument and accessories and/or subsequent restoration:

NORTH QUARTER CORNER SECTION 3, T6S, R6W.

1882: Knowles, Surveyor - .67½ w. from Girard ¼ corner.

B. Description of corner evidence found and/or method applied in restoring or reestablishing corner:


Dug large hole, unable to locate any trace of corner.

Set ½" x 18" rebar iron with ID cap in CI-monument box on north section line and equal distance between northeast and northwest corner of section.

C. Description of monument for corner and accessories established to perpetuate locating the position of the corner:

Rebar iron as noted above.
N 85 E 118.9', near face of power pole.
N 77 W 207.5', near face of power pole.
Due south 7.2', C/L of east-west road.
S 5 E 52.6', center of 6" Fir tree.

And is accepted as a careful and faithful reestablishment of the position of the original corner.

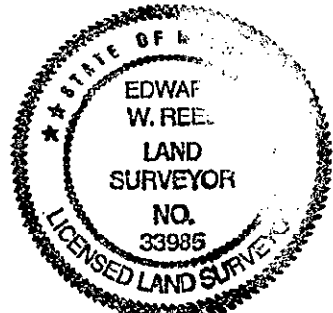

Signed by Edward W. Reed Date November 30, 1993
Surveyor's Michigan License No. 33985