

1993

BRANCH COUNTY REMONUMENTAION CORNER

LAND CORNER RECORDATION CERTIFICATE

Filing Requirement of Act 74, Mich. P.A. 1970

COMMISSION

For corners in

BRANCH

(County)

Located In:

Corner Code ##

- 1. Public Land Survey T 6S R 6W I-1
- T _____ R _____
- T _____ R _____
- T _____ R _____
- 2. Property Controlling S _____ T _____ R _____
- in Section S _____ T _____ R _____
- 3. Miscellaneous S _____ T _____ R _____
- Property in Sec. S _____ T _____ R _____

253

REGISTER OF DEEDS

93 DEC 27 AM 10:07

REC'D FOR RECORD STATE OF MICHIGAN BRANCH COUNTY

Register of Deeds Stamp & File Number

- 4. Lot No. _____, Recorded Plat _____
- 5. Private Claims _____

| | A | B | C | D | E | F | G | H | I | J | K | L | M |
|----|----|---|----|---|----|---|----|---|----|---|----|---|---|
| 2 | 6 | | 5 | | 4 | | 3 | | 2 | | 1 | | |
| 3 | | | | | | | | | | | | | |
| 4 | 7 | | 8 | | 9 | | 10 | | 11 | | 12 | | |
| 5 | | | | | | | | | | | | | |
| 6 | 18 | | 17 | | 16 | | 15 | | 14 | | 13 | | |
| 7 | | | | | | | | | | | | | |
| 8 | 19 | | 20 | | 21 | | 22 | | 23 | | 24 | | |
| 9 | | | | | | | | | | | | | |
| 10 | 30 | | 29 | | 28 | | 27 | | 26 | | 25 | | |
| 11 | | | | | | | | | | | | | |
| 12 | 31 | | 32 | | 33 | | 34 | | 35 | | 36 | | |
| 13 | | | | | | | | | | | | | |

I, Edward W. Reed, in a field survey on November 22, 19 93, do hereby certify that under requirements of P.A. 74, Michigan P.A. of 1970, the corner points mentioned in lines 1 and 2 above were in conformance with regulations and rules therefore as required in the current manual of survey instructions of the United States Department of the Interior, Bureau of Land Management or by a decree of a Court of Law and/or that the corner points mentioned in lines 3, 4 and 5 above were in conformance with the rules of the Michigan Board of Land Surveyors or by a Decree of a Court of Law; established, re-established, monumented, re-monumented, recovered, found as expressed below:

NOTE: Not more than 4 corners, all in the same town and range, may be recorded on this certificate.

A. Description of original monument and accessories and/or subsequent restoration:

NE corner section 3, NW corner section 2, T6S, R6W

- 1825: W. Brookfield, GLODep. Surveyor; Set corner post- W. Ash 30", S48W 46; Sugar 24", S36E 31
- 1882: Knowles, Surveyor- 1.00 w. from Girard corner, this being the difference given in US minutes.
- 1963: Max Statler, Survey chief MSHD- 3/4" pipe, and witness.

B. Description of corner evidence found and/or method applied in restoring or reestablishing corner:


Dug down 2.0' through new road and found 3/4" pipe as described in MSHD notes, all witness now gone.

Set 1/2" x 18" rebar iron with ID cap in CI monument box.

C. Description of monument for corner and accessories established to perpetuate locating the position of the corner:

- Rebar iron stake as noted above.
- East 66.0', Girard Section corner
- N 75 E 107.50'. Nail and tag in south side 30" Maple
- S 50 E 53.70, Telephone pedestal
- N 25 W 31.0', North end of 36" CMP culvert
- S 25 W 78.5', South end of 36" CMP culvert

And is accepted as a careful and faithful perpetuation of the position of the original corner.

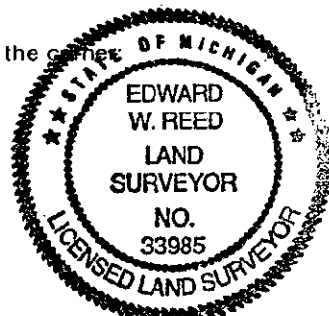

Signed by Edward W. Reed

Date NOVEMBER 22, 1993

Surveyor's Michigan License No. 33985