

# SURVEY & REMONUMENTATION

MAR 21 1997

COMMISSION

## BRANCH COUNTY REMONUMENTATION CORNER LAND CORNER RECORDATION CERTIFICATE

Filing Requirement of Act 74, Mich. P.A. 1970

STATE OF MICHIGAN  
Branch County  
Recorded

10-30-1996 09:19:03

Linda Lee Morrison-Mathews  
REGISTER OF DEEDS

Liber **00003** Page **0069**  
Register of Deeds Stamp & File Number

For corners in

BRANCH <small>(County)</small>	Located In:	Corner Code #
COLDWATER TWP.	T <u>6S</u> R <u>6W</u>	<u>I-3</u>
1. Public Land Survey	T _____ R _____	_____
2. Property Controlling in Section	S _____ T _____ R _____	_____
3. Miscellaneous Property in Sec.	S _____ T _____ R _____	_____

4. Lot No. \_\_\_\_\_, Recorded Plat \_\_\_\_\_

5. Private Claims \_\_\_\_\_

	A	B	C	D	E	F	G	H	I	J	K	L	M
2	6	5	4	3	2	1							
3									●				
4	7	8	9	10	11	12							
5													
6	18	17	16	15	14	13							
7													
8	19	20	21	22	23	24							
9													
10	30	29	28	27	26	25							
11													
12	31	32	33	34	35	36							
13													

I, Edward W. Reed, in a field survey on JUNE 26, 1996  
do hereby certify that under requirements of P.A. 74, Michigan P.A. of 1970, the corner points mentioned  
in lines 1 and 2 above were in conformance with regulations and rules therefore as required in the  
current manual of survey instructions of the United States Department of the Interior, Bureau of Land  
Management or by a decree of a Court of Law and/or that the corner points mentioned in lines 3, 4 and 5  
above were in conformance with the rules of the Michigan Board of Land Surveyors or by a Decree of a  
Court of Law; established, re-established, monumented, re-monumented, recovered, found as  
expressed below:

**NOTE: Not more than 4 corners, all in the same town and range, may be recorded  
on this certificate.**

**A. Description of original monument and accessories and/or subsequent restoration:**

CORNER COMMON TO SECTIONS 2, 3, 10, & 11, COLDWATER TWP., T6S, R6W, BRANCH COUNTY MI.

- 1829: O. RISDON, DEP. SURVEY, CORNER SET
- 1851: H. CAREY, COUNTY SURVEYOR, SURVEY TIED TO CORNER
- 1865: A. DAY, COUNTY SURVEYOR, DESCRIBES CORNER AS "REDDISH SANDSTONE 2'3" LONG SET IN THE GROUND WITH BRICKBATS AROUND IT"
- 1877: J. BENNETT, COUNTY SURVEYOR, "STAKE FOUND, PLANTED BY CAREY"
- 1928: F. SOLL, RLS, STATE SCHOOL SURVEY, SET 3" BRASS CAP SET IN CONCRETE STANDARD STATE OF MI. MARKER
- 1963: CORBERT, SMHD, SURVEY CHIEF, FOUND 3" BRASS STATE OF MI MARKER
- 1982: E.R. REED CO. SURVEYOR, FOUND SQUARE HEADED IRON OVER BRASS MARKER, REC. LCR #11-060

**B. Description of corner evidence found and/or method applied in restoring or reestablishing corner:**

FOUND SQ HEADED BOLT OVER BRASS STATE OF MICHIGAN MARKER  
SET 1/2" x 3" IRON, REMONUMENTATION CAP IN CAST IRON BOX


ACCEPTED BY THE BRANCH COUNTY  
SURVEY PEER GROUP AS THE OFFICIAL  
CORNER UNDER MICHIGAN PUBLIC ACT 345  
OF 1990 AT A MEETING HELD ON  
Oct. 9, 1996

*E.R. Reed, Co. Rep.*

E.R. REED

**C. Description of monument for corner and accessories established to perpetuate locating the position of the corner:**

- 1/2" x 3" IRON, REMONUMENTATION CAP IN CAST IRON BOX
- S58E 49.7' TO NW CORNER OF SQ. CONCRETE POST
- 36W 60.8' TO NE CORNER OF TELEPHONE PEDESTAL
- N53W 46.8' TO SE CORNER OF TELEPHONE PEDESTAL
- N56E 48.2' TO SE CORNER OF TELEPHONE PEDESTAL
- N22E 91.4' TO NEAR FACE OF POWER POLE

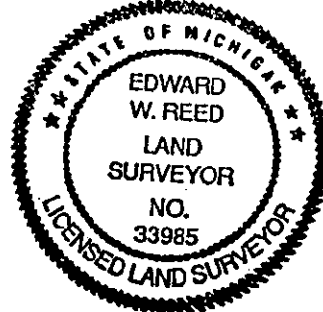

And is accepted as a careful and faithful perpetuation of the position of the original corner.

Signed by *Edward W. Reed* Date JUNE 26, 1996  
Edward W. Reed  
Surveyor's Michigan License No. 33985