

SURVEY & REMONUMENTATION

MAR 21 1997

COMMISSION

**BRANCH COUNTY REMONUMENTATION CORNER
LAND CORNER RECORDATION CERTIFICATE**

Filing Requirement of Act 74, Mich. P.A. 1970

STATE OF MICHIGAN
Branch County
Recorded

10-30-1996 09:19:11

Linda Lee Morrison-Mathews
REGISTER OF DEEDS

Liber 00003 Page 0070

Register of Deeds Stamp & File Number

For corners in

BRANCH _____
(County)

Located in:

Corner Code #

COLDWATER TWP.

- | | | |
|------------------------------------|-------------------------|-------|
| 1. Public Land Survey | T 6 S. R 6W. | I-5 |
| | T _____ R _____ | _____ |
| | T _____ R _____ | _____ |
| | T _____ R _____ | _____ |
| 2. Property Controlling in Section | S _____ T _____ R _____ | _____ |
| | S _____ T _____ R _____ | _____ |
| 3. Miscellaneous Property in Sec. | S _____ T _____ R _____ | _____ |
| | S _____ T _____ R _____ | _____ |

4. Lot No. _____, Recorded Plat _____
5. Private Claims _____

	A	B	C	D	E	F	G	H	I	J	K	L	M
2	6	5	4	3	2	1							
3													
4	7	8	9	10	11	12							
5													
6	18	17	16	15	14	13							
7													
8	19	20	21	22	23	24							
9													
10	30	29	28	27	26	25							
11													
12	31	32	33	34	35	36							
13													

I, Edward W. Reed, in a field survey on JUNE 26, 19 96, do hereby certify that under requirements of P.A. 74, Michigan P.A. of 1970, the corner points mentioned in lines 1 and 2 above were in conformance with regulations and rules therefore as required in the current manual of survey instructions of the United States Department of the Interior, Bureau of Land Management or by a decree of a Court of Law and/or that the corner points mentioned in lines 3, 4 and 5 above were in conformance with the rules of the Michigan Board of Land Surveyors or by a Decree of a Court of Law; established, re-established, monumented, re-monumented, recovered, found as expressed below:

NOTE: Not more than 4 corners, all in the same town and range, may be recorded on this certificate.

A. Description of original monument and accessories and/or subsequent restoration:

- CORNER COMMON TO SECTIONS 10, 11, 14, & 15, COLDWATER TWP., T6S, R6W, BRANCH COUNTY, MI
- 1829: O. RISDON, DEPUTY SURVEYOR, CORNER SET
- 1851: H. CARY, COUNTY SURVEYOR, SURVEY
- 1928: F. SOLL, RLS, STATE SCHOOL SURVEY, SET BRASS CAP IN CONCRETE
- 1955: E.R. REED, COUNTY SURVEYOR FOUND BRASS CAP 24" DEEP
- 1963" CORB.IT, MSHD, SURVEY CHIEF, FOUND 3"BRASS STATE OF MICHIGAN MARKER

B. Description of corner evidence found and/or method applied in restoring or reestablishing corner:


- FOUND 3/8" IRON IN CAST IRON BOX
- SET REMONUMENTATION CAP OVER IRON

ACCEPTED BY THE BRANCH COUNTY SURVEY PEER GROUP AS THE OFFICIAL CORNER UNDER MICHIGAN PUBLIC ACT 345 OF 1990 AT A MEETING HELD ON

Oct. 9, 1996
E.R. Reed, Co. Rep.
E.R. REED

C. Description of monument for corner and accessories established to perpetuate locating the position of the corner:

- 3/8" IRON WITH REMONUMENTATION CAP IN CAST IRON BOX
- N45E 53.10' TO FACE OF 24" GREEN SPRUCE
- S28E 105.3' TO 4"x5' HIGH GAS VENT PIPE
- S64E 94.1' TO PROPERTY CORNER IRON
- S70W 72.4' TO W END OF CONCRETE CURB

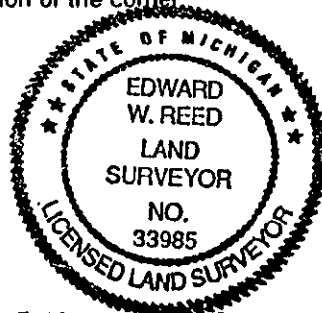

And is accepted as a careful and faithful perpetuation of the position of the original corner.

Signed by Edward W. Reed Date JUNE 26, 1996
Surveyor's Michigan License No. 33985