

1993

COMMISSION

BRANCH COUNTY REMONUMENTATION CORNER
LAND CORNER RECORDATION CERTIFICATE
Filing Requirement of Act 74, Mich. P.A. 1970

For corners in

Branch (County)	Located In:	Corner Code #
1. Public Land Survey	T <u>6S</u> R <u>6W</u>	<u>I-13</u>
	T _____ R _____	_____
	T _____ R _____	_____
	T _____ R _____	_____
2. Property Controlling in Section	S _____ T _____ R _____	_____
	S _____ T _____ R _____	_____
3. Miscellaneous Property in Sec.	S _____ T _____ R _____	_____
	S _____ T _____ R _____	_____

254

John J. Morrison
REGISTER OF DEEDS

93 DEC 27 AM 10:07

REC'D FOR RECORD
STATE OF MICHIGAN
BRANCH COUNTY

Register of Deeds Stamp & File Number

- 4. Lot No. _____, Recorded Plat _____
- 5. Private Claims _____

	A	B	C	D	E	F	G	H	I	J	K	L	M
2	6	5	4	3	2	1							
3													
4	7	8	9	10	11	12							
5													
6	18	17	16	15	14	13							
7													
8	19	20	21	22	23	24							
9													
10	30	29	28	27	26	25							
11													
12	31	32	33	34	35	36							
13													

I, Edward W. Reed, in a field survey on November 5, 1993, do hereby certify that under requirements of P.A. 74, Michigan P.A. of 1970, the corner points mentioned in lines 1 and 2 above were in conformance with regulations and rules therefore as required in the current manual of survey instructions of the United States Department of the Interior, Bureau of Land Management or by a decree of a Court of Law and/or that the corner points mentioned in lines 3, 4 and 5 above were in conformance with the rules of the Michigan Board of Land Surveyors or by a Decree of a Court of Law; established, re-established, monumented, re-monumented, recovered, found as expressed below:

NOTE: Not more than 4 corners, all in the same town and range, may be recorded on this certificate.

A. Description of original monument and accessories and/or subsequent restoration:

SOUTHEAST CORNER SECTION 34, SOUTHWEST CORNER SECTION 35, COLDWATER TOWNSHIP, T6S, R6W.

- 1825: W. Brookfield, GLO Dep. Surveyor: Set post corner, B. Ash 8", N53E 52; Beech 8", N42W 18
- 1910: Cox, Dep. County Surveyor: Found stone well planted
- 1963: Roon, Survey Chief, MSHD.: Found 3/4" pipe; 26" Maple, N20W 58.50'; Power Pole, N35W 40.45'; R.R. Tie fence post, S50E 72.05'.
- 1977: Reed, County Surveyor: Iron in Monument box., SE corner house, N44W 85.7'; 30" Maple, N7W 90.4'; C/L N-S road, east 22.0.

B. Description of corner evidence found and/or method applied in restoring or reestablishing corner:


Found 3/4" iron pipe in monument box 5" below road surface, large stone under pipe.
Set 1/2" x 18" rebar iron with I.D. cap in place of pipe, raised monument box to road surface.

C. Description of monument for corner and accessories established to perpetuate locating the position of the corner:

- Rebar iron stake as noted above:
- N 35 W 40.45' - Power pole
 - N 44 W 85.7' - SE corner house
 - N 7 W 90.4' - Center 30" Maple
 - East 22.0 - C/L N-S road
 - N 70 E 79.2' - SW corner telephone pedestal

And is accepted as a careful and faithful representation of the position of the original corner.

Signed by Edward W. Reed

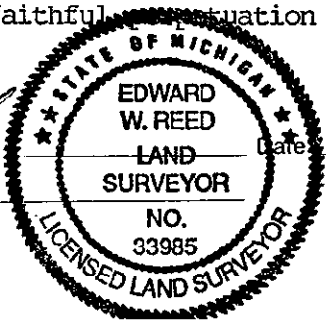

Date November 5, 1993

Surveyor's Michigan License No. 33985