

1993

BRANCH COUNTY REMONUMENTATION CORNER

LAND CORNER RECORDATION CERTIFICATE

Filing Requirement of Act 74, Mich. P.A. 1970

COMMISSION

For corners in

BRANCH (County)	Located In:	Corner Code #
1. Public Land Survey	T <u>6S</u> R <u>6W</u>	<u>J-3</u>
	T _____ R _____	_____
	T _____ R _____	_____
	T _____ R _____	_____
2. Property Controlling in Section	S _____ T _____ R _____	_____
	S _____ T _____ R _____	_____
3. Miscellaneous Property in Sec.	S _____ T _____ R _____	_____
	S _____ T _____ R _____	_____

256

REGISTER OF DEEDS
John J. Morrison

93 DEC 27 AM 10:07

REC'D FOR RECORD
STATE OF MICHIGAN
BRANCH COUNTY

Register of Deeds Stamp & File Number

- 4. Lot No. _____, Recorded Plat _____
- 5. Private Claims _____

	A	B	C	D	E	F	G	H	I	J	K	L	M
2	6		5	4	3					2			
3										●			
4	7	8	9	10	11	12							
5													
6	18	17	16	15	14	13							
7													
8	19	20	21	22	23	24							
9													
10	30	29	28	27	26	25							
11													
12	31	32	33	34	35	36							
13													

I, Edward W. Reed, in a field survey on November 8, 19 93, do hereby certify that under requirements of P.A. 74, Michigan P.A. of 1970, the corner points mentioned in lines 1 and 2 above were in conformance with regulations and rules therefore as required in the current manual of survey instructions of the United States Department of the Interior, Bureau of Land Management or by a decree of a Court of Law and/or that the corner points mentioned in lines 3, 4 and 5 above were in conformance with the rules of the Michigan Board of Land Surveyors or by a Decree of a Court of Law; established, re-established, monumented, re-monumented, recovered, found as expressed below:

NOTE: Not more than 4 corners, all in the same town and range, may be recorded on this certificate.

A. Description of original monument and accessories and/or subsequent restoration:

- 1825: W. Brookfield, GLO Dept. Surveyor - Set quarter section post.
- 1892: I.D. Miner, Surveyor - Found stone set by Bennett, deposit broken fine clay.
- 1893: C. Hamilton, Surveyor - Found corner well planted.
- 1931: R.V. Terrill, Surveyor - Found stone, broken tile & crockery.
- 1967: Welke, Survey chief MSHD, set 3/4" Iron rod in monument box.
- 1967: E.R. Reed, County Surveyor - Reset N 1/4 corner, due to I-69 road construction, set 7/8" x 30 steel pin in blacktop pavement on approach to bridge.


B. Description of corner evidence found and/or method applied in restoring or reestablishing corner:

All witness of all previous surveyors now gone.
 Found 7/8" steep pin in bridge approach as described by E.R. Reed, County Surveyor.
 Set 1/2" x 18" rebar iron with ID cap in CI-monument box.

C. Description of monument for corner and accessories established to perpetuate locating the position of the corner:

Rebar iron as stated above.
 North 1.5', C/L east-west road
 S 21 E 18.8', End of steel I-beam post of guard rail.
 N 68 W 69.8', End of steel I-beam post of north guard rail.
 West 331.0', East end of I-69 bridge.

And is accepted as a careful and faithful perpetuation of the position of the original corner.

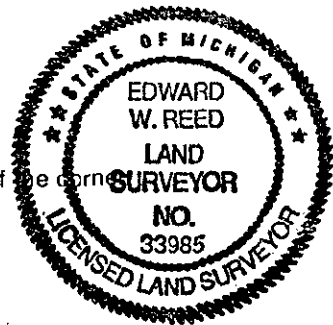

Signed by Edward W. Reed Date November 8, 1993

Surveyor's Michigan License No. 33985