

1993

BRANCH COUNTY REMONUMENTATION CORNER

LAND CORNER RECORDATION CERTIFICATE

Filing Requirement of Act 74, Mich. P.A. 1970

COMMISSION

For corners in BRANCH

(County)

Located In:

Corner Code #

- 1. Public Land Survey T 6S R 6W J-13
2. Property Controlling in Section S T R
3. Miscellaneous Property in Sec. S T R

257

REC'D FOR RECORD STATE OF MICHIGAN BRANCH COUNTY 93 DEC 27 AM 10:07 REGISTER OF DEEDS

Register of Deeds Stamp & File Number

- 4. Lot No. , Recorded Plat
5. Private Claims

Grid table with columns A-M and rows 2-13. A dot is marked in cell J13.

I, Edward W. Reed, in a field survey on November 30, 1993, do hereby certify that under requirements of P.A. 74, Michigan P.A. of 1970, the corner points mentioned in lines 1 and 2 above were in conformance with regulations and rules therefore as required in the current manual of survey instructions of the United States Department of the Interior, Bureau of Land Management or by a decree of a Court of Law and/or that the corner points mentioned in lines 3, 4 and 5 above were in conformance with the rules of the Michigan Board of Land Surveyors or by a Decree of a Court of Law; established, re-established, monumented, re-monumented, recovered, found as expressed below:

NOTE: Not more than 4 corners, all in the same town and range, may be recorded on this certificate.

A. Description of original monument and accessories and/or subsequent restoration:

SOUTH QUARTER CORNER SECTION 35, T6S, R6W

1825: W. Brookfield, GLO Dept. Surveyor
Set quarter section post. B. Ash 12", N63W 8
Beech 8", N83 1/2 E 27

B. Description of corner evidence found and/or method applied in restoring or reestablishing corner:


All evidence of old corner now gone due to digging of county ditch.

Set 1/2" x 18" rebar iron stake with ID cap in CI monument box at equal distance and on line between Southeast & Southwest Section corners.



C. Description of monument for corner and accessories established to perpetuate locating the position of the corner:

Rebar iron as noted above.
Due south 4.5', North edge road pavement
Due South 13.8', C/L E-W road
N 80 E 41.6', center of 12" Oak
S 40 E 75.8', center of 10" Oak

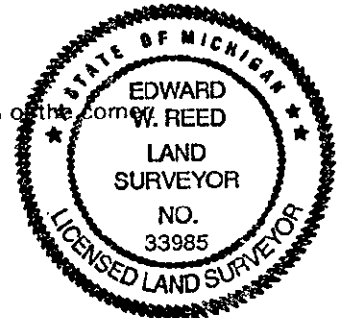

And is accepted as a careful and faithful reestablishment of the position of the original corner.

Signed by Edward W. Reed

Date November 30, 1993

Surveyor's Michigan License No. 33985