

**SURVEY &  
REMONUMENTATION**

1993

**BRANCH COUNTY REMONUMENTATION CORNER** **E MSC**

\*009.00

**COMMISSION**

**LAND CORNER RECORDATION CERTIFICATE**  
**Filing Requirement of Act 74, Mich. P.A. 1970**

For corners in  
**BRANCH**

	Located In:	Corner Code ##	
1. Public Land Survey	T <u>6S</u> R <u>6W</u>	<u>M-3</u>	
	T _____ R _____	_____	
	T _____ R _____	_____	
	T _____ R _____	_____	
2. Property Controlling in Section	S _____ T _____ R _____	_____	
	S _____ T _____ R _____	_____	
3. Miscellaneous Property in Sec.	S _____ T _____ R _____	_____	
	S _____ T _____ R _____	_____	

262

Register of Deeds Stamp & File Number

REC'D FOR RECORD  
 STATE OF MICHIGAN  
 BRANCH COUNTY  
 93 DEC 27 AM 10:07  
 Registrar of Deeds  
*John A. Morrison*

4. Lot No. \_\_\_\_\_, Recorded Plat \_\_\_\_\_  
 5. Private Claims \_\_\_\_\_

	A	B	C	D	E	F	G	H	I	J	K	L	M
2	6	5	4	3	2	1							
3													
4	7	8	9	10	11	12							
5													
6	16	17	18	15	14	13							
7													
8	19	20	21	22	23	24							
9													
10	30	29	28	27	26	25							
11													
12	31	32	33	34	35	36							
13													

I, Edward W. Reed in a field survey on November 2, 19 93, do hereby certify that under requirements of P.A. 74, Michigan P.A. of 1970, the corner points mentioned in lines 1 and 2 above were in conformance with regulations and rules therefore as required in the current manual of survey instructions of the United States Department of the Interior, Bureau of Land Management or by a decree of a Court of Law and/or that the corner points mentioned in lines 3, 4 and 5 above were in conformance with the rules of the Michigan Board of Land Surveyors or by a Decree of a Court of Law; established, re-established, monumented, re-monumented, recovered, found as expressed below:

**NOTE: Not more than 4 corners, all in the same town and range, may be recorded on this certificate.**

A. Description of original monument and accessories and/or subsequent restoration:

SE CORNER SECTION 1, NE CORNER SECTION 12, T6S, R6W

1829: W. Brookfield, GLO Dept. Surveyor. Set corner post: Beech 8", S15W 50; Sugar 12", N39½W 52

1930: R.V.Terrill, Surveyor. Found 2 stones side by side N & S with pieces of horseshoe, china & crockery: 20" Ash, N21W 71.4'; Center of conc. post, N38-30E 40.7'; 14" Maple, S70-15W 53.6'.

- E.R. Reed, County Surveyor. Found 3/4" pipe 16" deep from witness of R.V.Terrill. Center of conc. post, N38-30E 40.7'.

B. Description of corner evidence found and/or method applied in restoring or reestablishing corner:


Found 3/4" iron rod from witness of concrete post, N38-30E 40.7'.

Set ½" x 18" Rebar iron with I.D. cap in CI monument box.

C. Description of monument for corner and accessories established to perpetuate locating the position of the corner:

Rebar iron as noted above.  
 Center of concrete post, N 38° 30' E 40.7'  
 East wingwall @ south side bridge, S 66° E 38.8'  
 Power Pole, N 10° E 100.3'  
 west end 24" CMP, S 19° W 101.6'

And is accepted as a careful and faithful perpetuation of the position of the original corner.

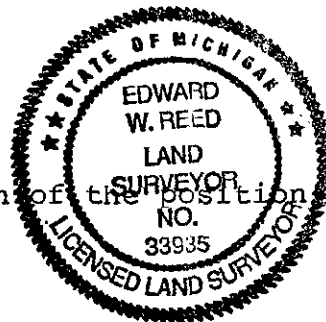

Signed by *Edward W. Reed* Date November 2, 1993  
 Surveyor's Michigan License No. 33985