

RF

Feb 17 1999

BRANCH COUNTY REMONUMATION PROGRAM
LAND CORNER RECORDATION CERTIFICATE
Filing Requirement of Act 74, Mich. P.A. 1970

STATE OF MICHIGAN
Branch County
Recorded

SECTION

11-08-1999 15:14:28

Linda Lee Morrison-Mathews
REGISTER OF DEEDS

For corners in

<u>BRANCH COUNTY</u> COLDWATER TWP	Located In:	Corner Code #
1. Public Land Survey	T <u>6</u> S R <u>6</u> W	<u>M-07</u>
	T _____ R _____	_____
	T _____ R _____	_____
	T _____ R _____	_____
2. Property Controlling in Section	S _____ T _____ R _____	_____
	S _____	_____
	T _____ R _____	_____
3. Miscellaneous	S _____	_____
	T _____ R _____	_____
Property in Sec.	S _____	_____
	T _____ R _____	_____

Liber 00004 Page 0030

Register of Deeds Stamp & File Number

4. Lot No. _____, Recorded Plat _____

5. Private Claims _____

I, EDWARD W. REED, in a field survey on JULY 12, 19 99 do hereby state that under requirements of P.A. 74, Michigan P.A. of 1970, the corner points mentioned in lines 1 and 2 above were in conformance with regulations and rules therefore as required in the current manual of survey instructions of the United States Department of the Interior, Bureau of Land Management or by a decree of a Court of Law and /or that the corner points mentioned in lines 3, 4 and 5 above were in conformance with the rules of the Michigan Board of Land Surveyors or by a Decree of a Court of Law; established, re-established, monumented, recovered, found as expressed below:

NOTE: Not more than 2 corners, all in the same town and range, may be recorded on this certificate.

SOUTHEAST CORNER SECTION 13
NORTHEAST CORNER SECTION 24

1	A	B	C	D	E	F	G	H	I	J	K	L	M
2	6		5		4		3		2		1		
3													
4	7		8		9		10		11		12		
5													
6	18		17		16		15		14		13		
7													
8	19		20		21		22		23		24		
9													
10	30		29		28		27		26		25		
11													
12	31		32		33		34		35		36		
13													

A. Description of original monument and accessories and/or subsequent restoration:

- 1825: JOHN MALLET, D.S., CORNER SET
E.R. REED, CO. SURVEYOR, OLD FILES INDICATES "STONE AND BRICK"
- 1975: E.R. REED, CO. SURVEYOR, "FOUND IRON AND BRICK"
- 1978: D. BOONE, RLS., SURVEY TIED TO CORNER
- 1983: E.R. REED, RLS., SURVEY TIED TO CORNER
- 1996: WM. CRANE, RLS., SURVEY TIED TO CORNER


ACCEPTED BY THE BRANCH COUNTY SURVEY PEER GROUP AS THE OFFICIAL CORNER UNDER MICHIGAN PUBLIC ACT 345 OF 1990 AT A MEETING HELD ON 10-06-1999
E.R. Reed, Co. Rep.
E.R. REED

B. Description of corner evidence found and/or method applied in restoring or reestablishing corner:

FOUND 1/2" IRON IN CAST IRON MONUMENT BOX FITTING ALL WITNESSES OF E.R. REED IN SURVEY #7903 SET REMON CAP ON IRON

C. Description of monument for corner and accessories established to perpetuate locating the position of the corner:

- N 18 E 98.9' FACE OF POWER POLE
- S 22 E 75.5' FACE OF POWER POLE
- N 83 W 15.9' FACE OF STEEL POST IN CONCRETE
- EAST 5.5' CENTERLINE OF ROAD

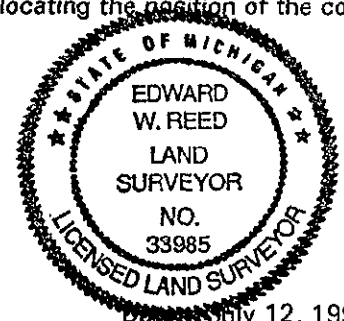

AND IS ACCEPTED AS A CAREFUL AND FAITHFUL PERPETUATION OF THE POSITION OF THE ORIGINAL CORNER.

Signed by Edward W. Reed
EDWARD W. REED

DATE: July 12, 1999

Surveyor's Michigan License No. 33985