

1993

BRANCH COUNTY REMONUMENTATION CORNER

LAND CORNER RECORDATION CERTIFICATE

Filing Requirement of Act 74, Mich. P.A. 1970

COMMISSION

For corners in

BRANCH

(County)

Located In:

Corner Code #

- | | | |
|------------------------------------|-------------------------|-------------|
| 1. Public Land Survey | T <u>6S</u> R <u>6W</u> | <u>M-11</u> |
| | T _____ R _____ | _____ |
| | T _____ R _____ | _____ |
| | T _____ R _____ | _____ |
| 2. Property Controlling in Section | S _____ T _____ R _____ | _____ |
| | S _____ T _____ R _____ | _____ |
| 3. Miscellaneous Property in Sec. | S _____ T _____ R _____ | _____ |
| | S _____ T _____ R _____ | _____ |

263

Register of Deeds
John J. Morrison

93 DEC 27 AM 10:07

REC'D FOR RECORD
STATE OF MICHIGAN
BRANCH COUNTY

Register of Deeds Stamp & File Number

4. Lot No. _____, Recorded Plat _____
5. Private Claims _____

	A	B	C	D	E	F	G	H	I	J	K	L	M
2	6	5	4	3	2	1							
3													
4	7	8	9	10	11	12							
5													
6	18	17	16	15	14	13							
7													
8	19	20	21	22	23	24							
9													
10	30	29	28	27	26	25							
11													
12	31	32	33	34	35	36							
13													

I, EDWARD W. REED, in a field survey on NOVEMBER 5, 19 93, do hereby certify that under requirements of P.A. 74, Michigan P.A. of 1970, the corner points mentioned in lines 1 and 2 above were in conformance with regulations and rules therefore as required in the current manual of survey instructions of the United States Department of the Interior, Bureau of Land Management or by a decree of a Court of Law and/or that the corner points mentioned in lines 3, 4 and 5 above were in conformance with the rules of the Michigan Board of Land Surveyors or by a Decree of a Court of Law; established, re-established, monumented, re-monumented, recovered, found as expressed below:

NOTE: Not more than 4 corners, all in the same town and range, may be recorded on this certificate.

A. Description of original monument and accessories and/or subsequent restoration:

SE CORNER SECTION 15, NORTHEAST CORNER SECTION 36, COLDWATER TOWNSHIP, T6S, R6W

1825: W. Brookfield, GLO Dep. Surveyor - set post corner; Hickory, 14", S9W 22 Beech, 12", N49½W 45

1½" x 8 iron - Unknown

1980: E. R. Reed, County Surveyor

Found 1½" badly bent, reset ½"x18" rebar iron; Round anchor post, South 46.8'; N. edge blacktop pavement, south 11.0'; 12" Ash, N85W 44.3'.

B. Description of corner evidence found and/or method applied in restoring or reestablishing corner:

Found 1½" badly bent iron, also ½" ERR capped iron below, small stones and broken brick.

Placed CI- Monument box around ERR capped iron.

C. Description of monument for corner and accessories established to perpetuate locating the position of the corner:

Rebar iron stake as noted above.

N 32 E 8.2' - SE corner telephone pedestal

South 11.0 - North edge blacktop pavement


N 58 E 113.6' - SW corner house

N 15 E 43.5" - center 1" Maple

N 86 E 106.1' - center 1" Red Maple

West 3.6' - East face wood post

And us accepted as a careful and faithful perpetuation of the position of the original corner.

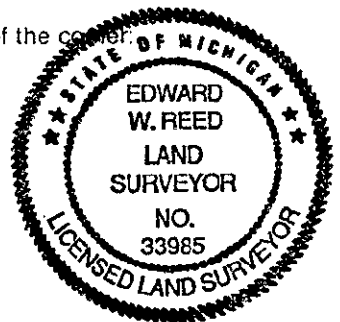

Signed by Edward W. Reed

Date November 5, 1993

Surveyor's Michigan License No. 33985