

SURVEY & REMONUMENTATION

FEB 08 1999

SECTION

**BRANCH COUNTY REMONUMENTATION PROGRAM
LAND CORNER RECORDATION CERTIFICATE
Filing Requirement of Act 74, Mich. P.A. 1970**

For corners in

<u>BRANCH COUNTY</u> BATAVIA TWP	Located In:	Corner Code #
1. Public Land Survey	T <u>6</u> S R <u>7</u> W	<u>M-4</u>
	T _____ R _____	_____
	T _____ R _____	_____
	T _____ R _____	_____
2. Property Controlling in Section	S _____ T _____ R _____	_____
	S _____	_____
	T _____ R _____	_____
3. Miscellaneous	S _____	_____
Property in Sec.	T _____ R _____	_____
	S _____	_____
	T _____ R _____	_____

STATE OF MICHIGAN
Branch County
Recorded

11-04-1998 15:46:46

Linda Lee Morrison-Mathews
REGISTER OF DEEDS

Register of Deeds Stamp & File Number

ACCEPTED BY THE BRANCH COUNTY
SURVEY PEER GROUP AS THE OFFICIAL
CORNER UNDER MICHIGAN PUBLIC ACT 345
OF 1990 AT A MEETING HELD ON

9-09-98

E.R. Reed, Co. Rep.

E.R. REED

4. Lot No. _____, Recorded Plat _____
5. Private Claims _____

	A	B	C	D	E	F	G	H	I	J	K	L	M		
1															
2	6			5			4			3			2	1	
3															
4	7						8			9			10	11	12
5															
6	18						17			16			15	14	13
7															
8	19						20			21			22	23	24
9															
10	30						29			28			27	26	25
11															
12	31						32			33			34	35	36
13															

I, EDWARD W. REED, in a field survey on MAY 29, 1998 do hereby state that under requirements of P.A. 74, Michigan P.A. of 1970, the corner points mentioned in lines 1 and 2 above were in conformance with regulations and rules therefore as required in the current manual of survey instructions of the United States Department of the Interior, Bureau of Land Management or by a decree of a Court of Law and /or that the corner points mentioned in lines 3, 4 and 5 above were in conformance with the rules of the Michigan Board of Land Surveyors or by a Decree of a Court of Law; established, re-established, monumented, recovered, found as expressed below:

NOTE: Not more than 2 corners, all in the same town and range, may be recorded on this certificate.

COMMON QUARTER CORNER TO SECTION 7, COLDWATER TWP
SECTION 12, BATAVIA TWP

A. Description of original monument and accessories and/or subsequent restoration:

1825: J. MALLET, D.S. - CORNER SET FOR M-4 BRONSON

1825: WM, BROOKFIELD, D.S. - GLO NOTES

1902: CHAS. HAMILTON, SURVEYOR - CORNER DUG OUT WHEN ROAD WAS BUILT, SET CORNER WITH DARK STONE & DEPOSIT OF OLD TIN & BRICK

E.R. REED, CO SURVEYOR - FOUND POINT STONE FROM OLD WITNESS OF HAMILTON, SET IRON ROD OVER STONE, RECORDED IN LCRC # II-024

B. Description of corner evidence found and/or method applied in restoring or reestablishing corner:

FOUND IRON ROD OVER STONE FITTING WITNESS OF LCRC II-024

C. Description of monument for corner and accessories established to perpetuate locating the position of the corner:

SET 1/2" X 18" REBAR IRON WITH REMON CAP IN CI-MONUMENT BOX FLUSH WITH PAVED ROAD SURFACE OVER STONE

40" OAK N 69 W 49.4' TO CENTER

30" OAK S 17 E 68.9' TO CENTER

TEL PED S 41 W 61.6' TO CENTER

POWER POLE N 46 W 46.9 TO FACE

NW CORNER OF OLD

SCHOOL HOUSE S 40 E 116.7'

5.3' EAST OF C/L OF N-S ROAD


AND IS ACCEPTED AS THE BEST AVAILABLE EVIDENCE OF THE POSITION OF THE ORIGINAL CORNER.

Signed by *Edward W. Reed*

EDWARD W, REED

Date SEPTEMBER 9, 1998

Surveyor's Michigan License No. 33985

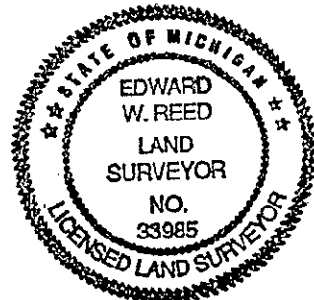

Liber 00003 Page 0216