

BRANCH COUNTY REMONUMENTATION PROGRAM
LAND CORNER RECORDATION CERTIFICATE
 Filing Requirement of Act 74, Mich. P.A. 1970

STATE OF MICHIGAN
 Branch County
 Recorded

SECTION

12-30-1999 11:02:47

Linda Lee Morrison-Mathews
 REGISTER OF DEEDS

Liber **00004** Page **0063**

Register of Deeds Stamp & File Number

ACCEPTED BY THE BRANCH COUNTY
 SURVEY PEER GROUP AS THE OFFICIAL
 CORNER UNDER MICHIGAN PUBLIC ACT 345
 OF 1990 AT A MEETING HELD ON
DEC. 27, 1999

E.R. Reed P.S.
 E.R. REED

For corners in

BRANCH COUNTY Located In: Corner Code #
MATTESON TWP

1. Public Land Survey T 6 S R 8 W C-13
 T R
 T R
 T R

2. Property Controlling in Section S T R
 S
 T R

3. Miscellaneous S
 T R
 Property in Sec. S
 T R

4. Lot No. _____, Recorded Plat _____

5. Private Claims _____

I, EDWARD W. REED, in a field survey on OCT 21, 19 99 do hereby state that under requirements of P.A. 74, Michigan P.A. of 1970, the corner points mentioned in lines 1 and 2 above were in conformance with regulations and rules therefore as required in the current manual of survey instructions of the United States Department of the Interior, Bureau of Land Management or by a decree of a Court of Law and /or that the corner points mentioned in lines 3, 4 and 5 above were in conformance with the rules of the Michigan Board of Land Surveyors or by a Decree of a Court of Law; established, re-established, monumented, recovered, found as expressed below:

NOTE: Not more than 2 corners, all in the same town and range, may be recorded on this certificate.

SOUTHEAST CORNER OF SECTION 31 AND THE SOUTHWEST CORNER OF SECTION 32

	A	B	C	D	E	F	G	H	I	J	K	L	M
1													
2		6		5		4		3		2		1	
3													
4		7		8		9		10		11		12	
5													
6		18		17		16		15		14		13	
7													
8		19		20		21		22		23		24	
9													
10		30		29		28		27		26		25	
11													
12		31		32		33		34		35		36	
13													

A. Description of original monument and accessories and/or subsequent restoration:

1825: JOHN MULLETT-CORNER SET
 1916: THOS. SHAVER-SET WELL POINT, 3 1/2' LONG, 2.70 CHAINS WEST OF C-1, BRONSON TWP.


B. Description of corner evidence found and/or method applied in restoring or reestablishing corner:

SEARCH OF AREA IN OLD FENCE LINE. ALL WITNESSES OF SHAVER NOW GONE AND NO EVIDENCE OF WELL POINT SET 1/2" X 18" REAR IRON AND REMON CAP IN OLD FENCE LINE AT 2.7 CHAINS (178.20') WEST OF FOUND CORNER (C-1, BRONSON)

C. Description of monument for corner and accessories established to perpetuate locating the position of the corner:

1/2" X 18" REBAR WITH REMON CAP WITH CARSONITE MARKER ON EAST SIDE
 IN FENCE LINE & WEST
 2.7 CHAINS EAST OF BRONSON CORNER
 TRIPLE 12" LOCUST EAST 1.6'
 DOUBLE LOCUST WEST 0.6'

AND IS ACCEPTED AS A CAREFUL AND FAITHFUL REESTABLISHMENT OF THE POSITION OF THE ORIGINAL CORNER.

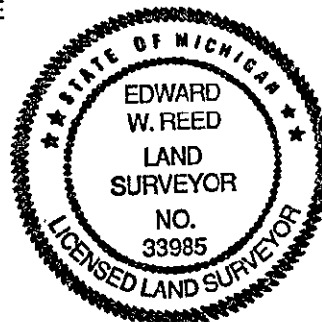

Signed by Edward W. Reed

Date OCT. 21, 1999

EDWARD W. REED

Surveyor's Michigan License No. 33985