

SURVEY & REMONUMENTATION

FEB 13 2001

**BRANCH COUNTY REMONUMENTATION
LAND CORNER RECORDATION CERTIFICATE
Filing Requirement of Act 74, Mich. P.A. 1970**

STATE OF MICHIGAN
Branch County
Recorded

12-15-2000 14:09:26

Linda Lee Morrison-Mathews
REGISTER OF DEEDS

Liber **00004** Page **0138**

Register of Deeds Stamp & File Number

For corners in **SECTION**

BRANCH _____	Located in:	Corner Code #
(County)		
MATTESON TOWNSHIP	T <u>6S</u> R <u>8W</u>	<u>1-1</u>
1. Public Land Survey	T _____ R _____	_____
	T _____ R _____	_____
	T _____ R _____	_____
2. Property Controlling	S _____ T _____ R _____	_____
in Section	S _____ T _____ R _____	_____
3. Miscellaneous	S _____ T _____ R _____	_____
Property in Sec.	S _____ T _____ R _____	_____

4. Lot No. _____, Recorded Plat _____
5. Private Claims _____

I, ROBERT R. CARR, in a field survey on NOVEMBER 15, 2000 do hereby state that under requirements of P.A. 74, Michigan P.A. of 1970, the corner points mentioned in lines 1 and 2 above were in conformance with regulations and rules therefore as required in the current manual of survey instructions of the United States Department of the Interior, Bureau of Land Management or by a decree of a Court of Law and /or that the corner points mentioned in lines 3, 4 and 5 above were in conformance with the rules of the Michigan Board of Land Surveyors or by a Decree of a Court of Law; established, re-established, monumented, recovered, found as expressed below:

NOTE: Not more than 2 corners, all in the same town and range, may be recorded on this certificate.

A. Description of original monument and accessories and/or subsequent restoration:

GLO: WILLIAM BROOKFIELD D.S. 1826
SURVEY BY I.D. MINER, 1895 IN SECTION 34, T6S, R8W, SET STONE 5 LINKS WEST OF CORNER OF SECTIONS 2 AND 3, MATTESON TOWNSHIP

	A	B	C	D	E	F	G	H	I	J	K	L	M
1													
2	6	5	4	3	2	1							
3													
4	7	8	9	10	11	12							
5													
6	18	17	16	15	14	13							
7													
8	19	20	21	22	23	24							
9													
10	30	29	28	27	26	25							
11													
12	31	32	33	34	35	36							
13													

ACCEPTED BY THE BRANCH COUNTY SURVEY PEER GROUP AS THE OFFICIAL CORNER UNDER MICHIGAN PUBLIC ACT 345 OF 1990 AT A MEETING HELD ON 11-28-2000
E. R. Reed, P.S.
E. R. REED, Co. REP.

B. Description of corner evidence found and/or method applied in restoring or reestablishing corner:


DUG AND FOUND DEPOSITION OF BRICK FOR SHERWOOD TOWNSHIP CORNER AND DEPOSIT OF BRICK AND EARTHEN 3.3 FEET EAST FOR MATTESON TOWNSHIP CORNER PER NOTES OF I.D. MINER 1895.
ACCEPTED LOCATION OF BRICK AND EARTHEN AS CORNER.

C. Description of monument for corner and accessories established to perpetuate locating the position of the corner:

STANDARD BRANCH COUNTY REMONUMENTATION 1/2" STEEL ROD WITH CAP STAMPED NO. 20704 IN MONUMENT BOX 6" BELOW GRAVEL SURFACE TELEPHONE RISER, N70°E 77.75 FEET
4" ELM, N42°E 52.50 FEET (NAIL AND SPOTTER)
6" MAPLE, N15°W 27.2 FEET (NAIL AND SPOTTER)
4" ELM, N53°W 39.87 FEET (NAIL AND SPOTTER)
5" W. CHERRY, S28°W 32.4 FEET (NAIL AND SPOTTER)
CORNER TO SECTIONS 34 AND 35, SHERWOOD TOWNSHIP, WEST 3.30 FEET.

AND IS ACCEPTED AS THE BEST AVAILABLE EVIDENCE OF THE POSITION OF THE ORIGINAL CORNER:

Signed by Robert R. Carr
Surveyor's Michigan License No. 20704 ROBERT R. CARR

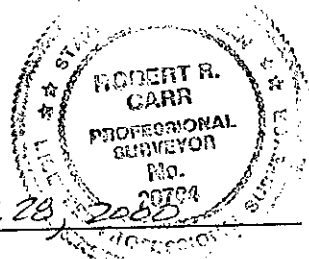

NOTICE
THIS COPY IS FOR BRANCH COUNTY DEPARTMENTAL MATTERS ONLY. THIS COPY NOT TO BE REPRODUCED OR SENT PUBLIC TO REGISTER OF DEEDS FOR CORNERS.

FORM APPROVED BY MICHIGAN STATE BOARD OF PROFESSIONAL SURVEYORS, JAN. 23, 1971
REVISED MAY 14, 1975
REVISED JAN., 1983
REVISED OCT., 1995