

SURVEY & REMONUMENTATION

MAR 13 1998

SECTION

BRANCH COUNTY REMONUMENTATION CORNER LAND CORNER RECORDATION CERTIFICATE Filing Requirement of Act 74, Mich. P.A. 1970

STATE OF MICHIGAN Branch County Recorded

For corners in

Form with fields for BRANCH (County), Located In, Corner Code #, and numbered sections 1-5 for survey details.

10-22-1997 09:57:00

Linda Lee Morrison-Mathews REGISTER OF DEEDS

Liber 00003 Page 0167

Register of Deeds Stamp & File Number

I, EDWARD W. REED, in a field survey on JULY 18, 1997 do hereby state that under requirements of P.A. 74, Michigan P.A. of 1970, the corner points mentioned in lines 1 and 2 above were in conformance with regulations and rules therefore as required in the current manual of survey instructions of the United States Department of the Interior, Bureau of Land Management or by a decree of a Court of Law and /or that the corner points mentioned in lines 3, 4 and 5 above were in conformance with the rules of the Michigan Board of Land Surveyors or by a Decree of a Court of Law; established, re-established, monumented, recovered, found as expressed below:

Grid table with columns A-M and rows 1-13, containing numbers 1-36 and a black dot at row 7, column I.

NOTE: Not more than 2 corners, all in the same town and range, may be recorded on this certificate.

A. Description of original monument and accessories and/or subsequent restoration: CORNER COMMON TO SECTIONS 14-15-22-23

- 1826: WM BROOKFIELD, DEPT SURVEYOR - CORNER SET
1891: MINER, CO SURVEYOR - FOUND STONE
1969: MICH. STATE HIGHWAY DEPT., FIELD NOTES: FOUND RR SPIKE OVER BROKEN RED BRICK, SET 3/4" PIPE IN MONUMENT BOX.
1973: E.R.REED, CO SURVEYOR - FOUND 3/4" PIPE IN MONUMENT BOX, RECORDED IN LCRC # 0061

B. Description of corner evidence found and/or method applied in restoring or reestablishing corner:

FOUND 3/4" IRON PIPE IN MONUMENT BOX

C. Description of monument for corner and accessories established to perpetuate locating the position of the corner:


1/2" X18" REBAR IRON, REMON CAP IN CI-MONUMENT BOX

- 12" DIA STEEL COR POST, NORTH 33.0'
TWIN 12" WALNUT, N41E 38.8' TO CENTER
16" WALNUT, N62E 49.8' TO CENTER
24" MAPLE, S11E 25.0' TO CENTER
24" MAPLE, S70W 65.0 TO CENTER
4.3' SOUTH OF C/L E-W ROAD

AND IS ACCEPTED AS A CAREFUL AND FAITHFUL PERPETUATION OF THE POSITION OF THE ORIGINAL CORNER

Signed by [Signature] EDWARD W. REED Date JULY 18, 1997

Surveyor's Michigan License No. 33985

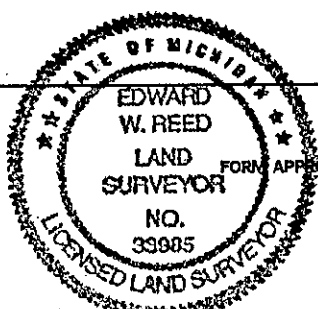

ACCEPTED BY THE BRANCH COUNTY SURVEY PEER GROUP AS THE OFFICIAL CORNER UNDER MICHIGAN PUBLIC ACT 343 OF 1990 AT A MEETING HELD ON 9-10-97

[Signature] E.R. REED

FORM APPROVED BY MICHIGAN STATE BOARD OF PROFESSIONAL SURVEYORS, JAN. 28 REVISED MAY 14, 1975

REVISED JAN, 198 REVISED OCT, 199