

FEB 08 1999

SECTION

BRANCH COUNTY REMONUMENTATION PROGRAM
LAND CORNER RECORDATION CERTIFICATE
Filing Requirement of Act 74, Mich. P.A. 1970

Libert 000003 Page 0259

For corners in

<u>BRANCH COUNTY</u> ALGANSEE TWP	Located In:	Corner Code #
1. Public Land Survey	T <u>7</u> S R <u>5</u> W	<u>C-11</u>
	T _____ R _____	_____
	T _____ R _____	_____
	T _____ R _____	_____
2. Property Controlling	S _____ T _____ R _____	_____
in Section	S _____	_____
	T _____ R _____	_____
3. Miscellaneous	S _____	_____
	T _____ R _____	_____
Property in Sec.	S _____	_____
	T _____ R _____	_____

STATE OF MICHIGAN
Branch County
Recorded

12-07-1998 13:54:51

Linda Lee Morrison-Mathews
REGISTER OF DEEDS

Register of Deeds Stamp & File Number

ACCEPTED BY THE BRANCH COUNTY
SURVEY PEER GROUP AS THE OFFICIAL
CORNER UNDER MICHIGAN PUBLIC ACT 365
OF 1990 AT A MEETING HELD ON
11-04-1998

E. B. Reed, Co. Rep.
E. R. REED

- 4. Lot No. _____, Recorded Plat _____
- 5. Private Claims _____

I, EDWARD W. REED, in a field survey on OCTOBER 30, 19 98 do hereby state that under requirements of P.A. 74, Michigan P.A. of 1970, the corner points mentioned in lines 1 and 2 above were in conformance with regulations and rules therefore as required in the current manual of survey instructions of the United States Department of the Interior, Bureau of Land Management or by a decree of a Court of Law and /or that the corner points mentioned in lines 3, 4 and 5 above were in conformance with the rules of the Michigan Board of Land Surveyors or by a Decree of a Court of Law; established, re-established, monumented, recovered, found as expressed below:

NOTE: Not more than 2 corners, all in the same town and range, may be recorded on this certificate.

CORNER COMMON TO SECTIONS 29-30-31-32

A. Description of original monument and accessories and/or subsequent restoration:

- 1825: WM BROOKFIELD, DEPT SURVEYOR - CORNER SET
- 1880: M. KNOWLES, SURVEYOR - FOUND STAKE & BRICK
- 1980: E.R. REED, CO. SURVEYOR - FROM OLD WITNESS, FOUND 1 1/4" DIA ROUND WOOD STAKE IN OCTAGONAL GLAZED BRICK, SET 3/4" IRON PIN ON TOP WITH NEW WITNESS

B. Description of corner evidence found and/or method applied in restoring or reestablishing corner:

FOUND IRON STAKE IN GLAZED BRICK FITTING WITNESS OF E.R. REED

C. Description of monument for corner and accessories established to perpetuate locating the position of the corner:

SET 1/2" X 18" REBAR IRON WITH REMON CAP IN CI-MONUMENT BOX, FLUSH WITH PAVED ROAD SURFACE

NW CORNER CONC. BLOCK HOUSE	S 06 E	100.25'
POWER POLE	S 40 E	142.85'
CENTER OF 46" OAK	S 02 W	66.0'
CENTER OF 46" OAK	S 06 W	24.1'
TELEPHONE PED	S 31 W	31.37'


AND IS ACCEPTED AS THE BEST AVAILABLE EVIDENCE OF THE POSITION OF THE ORIGINAL CORNER.

Signed by *Edward W. Reed*

EDWARD W, REED

Surveyor's Michigan License No. 33985

Date Nov. 4, 1998

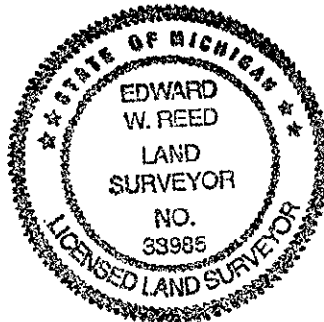

	A	B	C	D	E	F	G	H	I	J	K	L	M
1													
2	6		5		4		3		2		1		
3													
4	7		8		9		10		11		12		
5													
6	18		17		16		15		14		13		
7													
8	19		20		21		22		23		24		
9													
10	30		29		28		27		26		25		
11													
12	31		32		33		34		35		36		
13													