

**SURVEY &
REMONUMENTATION**

JAN 23 1996

**BRANCH COUNTY REMONUMENTATION CORNER
LAND CORNER RECORDATION CERTIFICATE
Filing Requirement of Act 74, Mich. P.A. 1970**

For corners in

COMMISSION

Branch _____ <small>(County)</small>	Located In:	Corner Code #:
ALGANSEE TOWNSHIP		
1. Public Land Survey	T <u>7</u> S R <u>5</u> W	<u>D-5</u>
	T _____ R _____	_____
	T _____ R _____	_____
	T _____ R _____	_____
2. Property Controlling in Section	S _____ T _____ R _____	_____
	S _____ T _____ R _____	_____
3. Miscellaneous Property in Sec.	S _____ T _____ R _____	_____
	S _____ T _____ R _____	_____
4. Lot No. _____, Recorded Plat _____		
5. Private Claims _____		

STATE OF MICHIGAN
Branch County
Recorded

12-01-1995 10:22:09

Linda Lee Morrison-Mathews
REGISTER OF DEEDS

Register of Deeds Stamp & File Number

Liber 00003 Page 0044

I, Edward W. Reed, in a field survey on September 25, 19 95, do hereby certify that under requirements of P.A. 74, Michigan P.A. of 1970, the corner points mentioned in lines 1 and 2 above were in conformance with regulations and rules therefore as required in the current manual of survey instructions of the United States Department of the Interior, Bureau of Land Management or by a decree of a Court of Law and/or that the corner points mentioned in lines 3, 4 and 5 above were in conformance with the rules of the Michigan Board of Land Surveyors or by a Decree of a Court of Law; established, re-established, monumented, re-monumented, recovered, found, as expressed below:

NOTE: Not more than 4 corners, all in the same town and range, may be recorded on this certificate.

	A	B	C	D	E	F	G	H	I	J	K	L	M
2	6	5	4	3	2	1							
3													
4	7	8	9	10	11	12							
5		●											
6	18	17	16	15	14	13							
7													
8	19	20	21	22	23	24							
9													
10	30	29	28	27	26	25							
11													
12	31	32	33	34	35	36							
13													

A. Description of original monument and accessories and/or subsequent restoration:

- 1825: Brookfield, corner set
- 1856: Cary, used corner in survey
- 1875: Knowles, found wood marked by Cary, planted a stove for corner above the stake
- 1891: Bennett, found stone
- 1909: Cox, found stone well planted
- 1993: E. W. Reed, found iron rod over stone

Quarter corner common to Sections 8 and 17, Towns 7 South, Range 5 West, Algansee Township, Branch County, Michigan.

B. Description of corner evidence found and/or method applied in restoring or reestablishing corner:


- Found 1/2" iron over stone
- Set remonumentation cap on top of iron, cast iron box flush with the road surface

ACCEPTED BY THE BRANCH COUNTY
SURVEY PEER GROUP AS THE OFFICIAL
CORNER UNDER MICHIGAN PUBLIC ACT 345
OF 1990 AT A MEETING HELD ON
Nov. 07, 1995

E.R. Reed, Co. Rep.

C. Description of monument for corner and accessories established to perpetuate locating the position of the corner:

- 1/2" rebar as noted above:
- S 70 W 75.4' center of 30" maple
 - S 44 W 114.8' NE corner old school
 - S 50 W 43.1' telephone pedestal
 - Due 840.22' iron stake on Section line
 - N 22 E 80.4' S end drive culvert

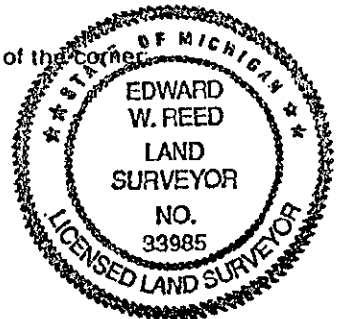

And is accepted as a careful and faithful perpetuation of the position of the original corner.

Signed by Edward W. Reed Date September 25, 1995
Surveyor's Michigan License No. 33985