

FEB 08 1999

SECTION

BRANCH COUNTY REMONUMENTATION PROGRAM
LAND CORNER RECORDATION CERTIFICATE
Filing Requirement of Act 74, Mich. P.A. 1970

For corners in

<u>BRANCH COUNTY</u>	Located In:	Corner Code #
ALGANSEE TWP		
1. Public Land Survey	T <u>7</u> S R <u>5</u> W	<u>E-11</u>
	T _____ R _____	_____
	T _____ R _____	_____
	T _____ R _____	_____
2. Property Controlling in Section	S _____ T _____ R _____	_____
	S _____	_____
	T _____ R _____	_____
3. Miscellaneous	S _____	_____
	T _____ R _____	_____
Property in Sec.	S _____	_____
	T _____ R _____	_____

STATE OF MICHIGAN
Branch County
Recorded

12-07-1998 13:54:59

Linda Lee Morrison-Mathews
REGISTER OF DEEDS

Register of Deeds Stamp & File Number

Liber **00003** Page **0260**

4. Lot No. _____, Recorded Plat _____

5. Private Claims _____

I, EDWARD W. REED, in a field survey on JULY 10, 1998 do hereby state that under requirements of P.A. 74, Michigan P.A. of 1970, the corner points mentioned in lines 1 and 2 above were in conformance with regulations and rules therefore as required in the current manual of survey instructions of the United States Department of the Interior, Bureau of Land Management or by a decree of a Court of Law and /or that the corner points mentioned in lines 3, 4 and 5 above were in conformance with the rules of the Michigan Board of Land Surveyors or by a Decree of a Court of Law; established, re-established, monumented, recovered, found as expressed below:

NOTE: Not more than 2 corners, all in the same town and range, may be recorded on this certificate.

CORNER COMMON TO SECTIONS 28-29-32-33

A. Description of original monument and accessories and/or subsequent restoration:

1825: WM BROOKFIELD, DEPT SURVEYOR - CORNER SET
1980: E. R. REED, CO SURVEYOR - FOUND LARGE RED STONE 10" DEEP, WITNESSED

B. Description of corner evidence found and/or method applied in restoring or reestablishing corner:

FOUND 1 1/2" X 16" SOLID IRON OVER STONE

C. Description of monument for corner and accessories established to perpetuate locating the position of the corner:


SET 1/2" X 18" REBAR IRON WITH REMON CAP IN CI-MONUMENT BOX FLUSH WITH PAVED ROAD SURFACE

TEL. PED	N56E	49.1' TO FACE
ROUND CORNER POST	N50E	45.2' TO FACE
RR TIE CORNER POST	N16E	40.85' TO SE CORNER
TEL PED	S17W	29.5' TO FACE
12" ASH	S57E	59.1' TO CENTER

	A	B	C	D	E	F	G	H	I	J	K	L	M
1													
2	6		5		4		3		2		1		
3													
4	7		8		9		10		11		12		
5													
6	13		17		16		15		14		13		
7													
8	19		20		21		22		23		24		
9													
10	30		29		28		27		26		25		
11													
12	31		32		33		34		35		36		
13													

ACCEPTED BY THE BRANCH COUNTY SURVEY PEER GROUP AS THE OFFICIAL CORNER UNDER MICHIGAN PUBLIC ACT 345 OF 1990 AT A MEETING HELD ON 11-04-1998

E.R. Reed Co. Rep.
E.R. REED

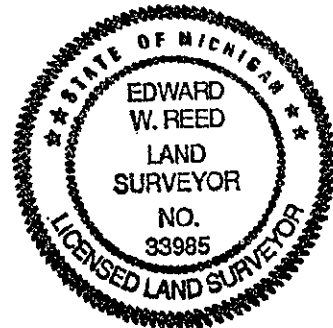

AND IS ACCEPTED AS A CAREFUL AND FAITHFUL PERPETUATION OF THE POSITION OF THE ORIGINAL CORNER.

Signed by Edward W. Reed
EDWARD W, REED

Date NOV. 4, 1998

Surveyor's Michigan License No. 33985