

FEB 08 1999

SECTION

BRANCH COUNTY REMONUMENTATION PROGRAM
LAND CORNER RECORDATION CERTIFICATE
Filing Requirement of Act 74, Mich. P.A. 1970

STATE OF MICHIGAN
Branch County
Recorded

12-07-1998 13:55:06

Linda Lee Morrison-Mathews
REGISTER OF DEEDS

Liber 00003 Page 0261

Register of Deeds Stamp & File Number

For corners in

<u>BRANCH COUNTY</u> ALGANSEE TWP.	Located in:	Corner Code #
1. Public Land Survey	T <u>7</u> S R <u>5</u> W	<u>F-11</u>
	T _____ R _____	_____
	T _____ R _____	_____
	T _____ R _____	_____
2. Property Controlling in Section	S _____ T _____ R _____	_____
	S _____ T _____ R _____	_____
3. Miscellaneous Property in Sec.	S _____ T _____ R _____	_____
	S _____ T _____ R _____	_____

4. Lot No. _____, Recorded Plat _____

5. Private Claims _____

I, EDWARD W. REED, in a field survey on JULY 12, 1998 do hereby state that under requirements of P.A. 74, Michigan P.A. of 1970, the corner points mentioned in lines 1 and 2 above were in conformance with regulations and rules therefore as required in the current manual of survey instructions of the United States Department of the Interior, Bureau of Land Management or by a decree of a Court of Law and /or that the corner points mentioned in lines 3, 4 and 5 above were in conformance with the rules of the Michigan Board of Land Surveyors or by a Decree of a Court of Law; established, re-established, monumented, recovered, found as expressed below:

NOTE: Not more than 2 corners, all in the same town and range, may be recorded on this certificate.

QUARTER CORNER COMMON TO SECTIONS 28 & 33

A. Description of original monument and accessories and/or subsequent restoration:

1825: WM. BROOKFIELD, DEPT. SURVEYOR - CORNER SET
1860: M. KNOWLES CO. SURVEYOR - RED CEDAR STAKE
1980: E. R. REED, CO. SURVEYOR - FOUND STONE 3" N-S BY 12" E-W ABT 18" DEEP, SET IRON ON TOP, WITNESSED

B. Description of corner evidence found and/or method applied in restoring or reestablishing corner:

FOUND 1/2" IRON IN CI-MONUMENT BOX FITTING WITNESS OF E. R. REED. CO SURVEYOR
SET REMON CAP ON IRON

C. Description of monument for corner and accessories established to perpetuate locating the position of the corner:

1/2" X 18" REBAR IRON WITH REMON CAP IN CI-MONUMENT BOX FLUSH WITH ROAD SURFACE

IN CENTERLINE OF ROADS N-S AND E-W
NE CORNER OF OLD STONE FOUNDATION
OF SCHOOL HOUSE


18" WALNUT TREE (CENTER OF)	S 45 W 161.5'
ROUND CORNER POST (FACE OF)	N 45 E 38.1'
18" MAPLE TREE (CENTER OF)	S 28 E 37.0'
20" COTTONWOOD TREE (CENTER OF)	S 60 W 52.7'
	N 17 W 42.6'

AND IS ACCEPTED AS A CAREFUL AND FAITHFUL PERPETUATION OF THE POSITION OF THE ORIGINAL CORNER

Signed by Edward W. Reed
EDWARD W. REED

Date NOV. 4, 1998

Surveyor's Michigan License No. 33985

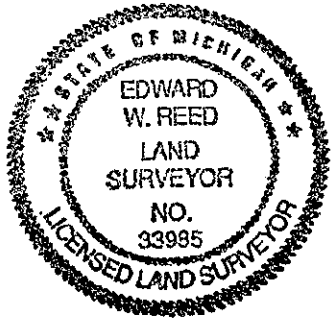

ACCEPTED BY THE BRANCH COUNTY SURVEY PEER GROUP AS THE OFFICIAL CORNER UNDER MICHIGAN PUBLIC ACT 345 OF 1990 AT A MEETING HELD ON 11-02-1998

E.R. Reed Co. Rep.
E.R. REED

A	B	C	D	E	F	G	H	I	J	K	L	M
1												
2	6		5		4		3		2		1	
3												
4	7		8		9		10		11		12	
5												
6	18		17		16		15		14		13	
7												
8	19		20		21		22		23		24	
9												
10	30		29		28		27		26		25	
11												
12	31		32		33		34		35		36	
13												

FORM APPROVED BY MICHIGAN STATE BOARD OF PROFESSIONAL SURVEYORS, JAN. 28, 1971
REVISED MAY 14, 1975
REVISED JAN., 1993
REVISED OCT., 1995