

**SURVEY &
REMONUMENTATION**

MAR 13 1998

#22822

SECTION

**BRANCH COUNTY REMONUMATION CORNER
LAND CORNER RECORDATION CERTIFICATE
Filing Requirement of Act 74, Mich. P.A. 1970**

For corners in

<u>BRANCH COUNTY</u>	Located In:	Corner Code #
ALGANSEE TWP		
1. Public Land Survey	T <u>7</u> S R <u>5</u> W	<u>G-11</u>
	T ___ R ___	_____
	T ___ R ___	_____
	T ___ R ___	_____
2. Property Controlling in Section	S ___ T ___ R ___	_____
	S ___ T ___ R ___	_____
3. Miscellaneous Property in Sec.	S ___ T ___ R ___	_____
	S ___ T ___ R ___	_____

STATE OF MICHIGAN
Branch County
Recorded

12-30-1997 10:04:44

Linda Lee Morrison-Mathews
REGISTER OF DEEDS

Liber **00003** Page **0187**

Register of Deeds Stamp & File Number

4. Lot No. _____, Recorded Plat _____
5. Private Claims _____

I, EDWARD W. REED, in a field survey on DECEMBER 3, 19 97 do hereby state that under requirements of P.A. 74, Michigan P.A. of 1970, the corner points mentioned in lines 1 and 2 above were in conformance with regulations and rules therefore as required in the current manual of survey instructions of the United States Department of the Interior, Bureau of Land Management or by a decree of a Court of Law and /or that the corner points mentioned in lines 3, 4 and 5 above were in conformance with the rules of the Michigan Board of Land Surveyors or by a Decree of a Court of Law; established, re-established, monumented, recovered, found as expressed below:

NOTE: Not more than 2 corners, all in the same town and range, may be recorded on this certificate.

	A	B	C	D	E	F	G	H	I	J	K	L	M
1													
2	6		5		4		3		2		1		
3													
4	7		8		9		10		11		12		
5													
6	18		17		16		15		14		13		
7													
8	19		20		21		22		23		24		
9													
10	30		29		28		27		26		25		
11													
12	31		32		33		34		35		36		
13													

ACCEPTED BY THE BRANCH COUNTY SURVEY PEER GROUP AS THE OFFICIAL CORNER UNDER MICHIGAN PUBLIC ACT 345 OF 1990 AT A MEETING HELD ON 12-08-97

E.R. Reed
E.R. REED

CORNER COMMON TO SECTIONS 27-28-33-34

A. Description of original monument and accessories and/or subsequent restoration:


- 1825: WM BROOKFIELD, DEPT SURVEYOR - CORNER SET
- 1860: WM KNOWLES, CO SURVEYOR - STONE
: OLD NOTES OF PRESENT CO SURVEYOR - "IRON"
- 1997: E.W. REED, SURVEYOR - FOUND 3/4" SQUARE HEAD BOAT SPIKE, UNABLE TO REMOVE, SET 1/2" IRON OVER TOP AND SET CI-MONUMENT BOX FLUSH WITH ROAD SURFACE, RECORDED IN LCRC # III-0124

B. Description of corner evidence found and/or method applied in restoring or reestablishing corner:

FOUND 1/2" IRON ROD IN CI-MONUMENT BOX AS DESCRIBED IN LCRC III-0124
SET REMON CAP ON IRON

C. Description of monument for corner and accessories established to perpetuate locating the position of the corner:

- 1/2" IRON ROD WITH REMON ÇAP IN CI-MONUMENT BOX FLUSH WITH ROAD SURFACE
- NE CORNER OF 2' SQUARE CONC. ANCHOR POST, S 45 W 41.2'
- RR RAIL POST, N 40 W 51.5'
- RR RAIL POST, N 65 W 58.6'
- RR TIE POST, N 45 E 42.2'
- TEL PED, N 45 E 38.7'
- TEL PED, N 70 E 70.2'

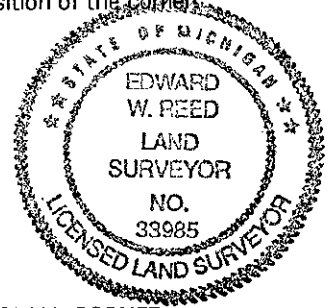

AND IS ACCEPTED AS A CAREFUL AND FAITHFUL PERPETUATION OF THE POSITION OF THE ORIGINAL CORNER

Signed by *Edward W. Reed*
EDWARD W. REED

Date 12.3.97

Surveyor's Michigan License No. 33985