SURVEY & REMONUMENTATION

FEB 13 2001

SECTION

BRANCH COUNTY REMONUMENTATION PROGRAM
LAND CORNER RECORDATION CERTIFICATE
Filing Requirement of Act 74, Mich. P.A. 1970

STATE OF MICHIGAN
Branch County
Recorded

12-15-2000 14:10:05

Linda Lee Morrison-Mathews
REGISTER OF DEEDS

Liber 00004 Page 0142

Register of Deeds Stamp & File Number

For corners in

BRANCH COUNTY
ALGANSEE TWP

	Located In:	Corner Code #
1. Public Land Survey	T 7 S R 5 W	H-5
	T____ R____	
	T____ R____	
	T____ R____	
2. Property Controlling	S____ T____ R____	
in Section	S____	
	T____ R____	
3. Miscellaneous	S____	
	T____ R____	
Property in Sec.	S____	
	T____ R____	

ACCEPTED BY THE BRANCH COUNTY SURVEY PEER GROUP AS THE OFFICIAL CORNER UNDER MICHIGAN PUBLIC ACT 345 OF 1990 AT A MEETING HELD ON 11-28-2000.

E.R. Reed P.S.
E.R. REED, Co. Rep.

4. Lot No. _____ , Recorded Plat _____

5. Private Claims _____

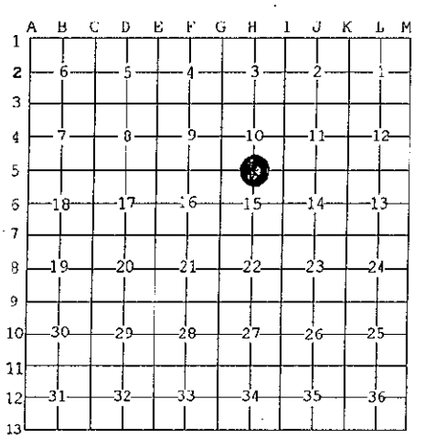

I, EDWARD W. REED, in a field survey on APRIL 20, 2000 do hereby state that under requirements of P.A. 74, Michigan P.A. of 1970, the corner points mentioned in lines 1 and 2 above were in conformance with regulations and rules therefore as required in the current manual of survey instructions of the United States Department of the Interior, Bureau of Land Management or by a decree of a Court of Law and /or that the corner points mentioned in lines 3, 4 and 5 above were in conformance with the rules of the Michigan Board of Land Surveyors or by a Decree of a Court of Law; established, re-established, monumented, recovered, found as expressed below:

NOTE: Not more than 2 corners, all in the same town and range, may be recorded on this certificate.

QUARTER CORNER COMMON TO SECTIONS 10 & 15, ALGANSEE TWP., BRANCH COUNTY, MI

A. Description of original monument and accessories and/or subsequent restoration:

1825: WM. BROOKFIELD-CORNER SET
1957: KNOWLES-SURVEY-NO NOTES ON CORNER

B. Description of corner evidence found and/or method applied in restoring or reestablishing corner:

SPLIT FENCE LINES NORTH & SOUTH AND OLD POST NORTH
DUG AND FOUND POINTED STONE & BRICK @ DEPTH OF 26"
SET ½" X 18" REBAR IRON WITH REMON CAP IN CAST IRON REMONUMENTATION BOX FLUSH WITH PAVED ROAD SURFACE

C. Description of monument for corner and accessories established to perpetuate locating the position of the corner:

½" X 18" REBAR IRON WITH REMON CAP IN CAST IRON REMONUMENTATION BOX FLUSH WITH PAVED ROAD SURFACE IN LINE WITH FENCES NORTH & SOUTH

OLD POST HOLE	NORTH	33.2'
WEST SIDE 20" CHERRY TREE	SOUTH	34.00'
NORTH & WEST-WEST SIDE 36" MAPLE	NORTH	26.91'
NORTH & WEST-NORTH SIDE 42" MAPLE	S45E	101.52'

AND IS ACCEPTED AS A CAREFUL AND FAITHFUL PERPETUATION OF THE POSITION OF THE ORIGINAL CORNER.

Signed by Edward W. Reed DATED: 4-20-00

EDWARD W. REED

Surveyor's Michigan License No. 33985

THIS COPY IS FOR BRANCH COUNTY DEPARTMENTAL PRINTING PURPOSES ONLY. THIS COPY NOT TO BE REPRODUCED SEND PUBLIC TO REGISTER OF DEEDS FOR COPIES

FORM APPROVED BY MICHIGAN STATE BOARD OF PROFESSIONAL SURVEYORS, JAN. 28, 1971
REVISED MAY 14, 1975
REVISED JAN., 1983
REVISED OCT., 1995