

**SURVEY & MONUMENTATION**

**JAN 23 1996**

**BRANCH COUNTY REMONUMENTATION CORNER  
LAND CORNER RECORDATION CERTIFICATE**

**Filing Requirement of Act 74, Mich. P.A. 1970**

For corners in **COMMISSION**

STATE OF MICHIGAN  
Branch County  
Recorded

12-01-1995 10:24:47


Linda Lee Morrison-Mathews  
REGISTER OF DEEDS

Liber **00003** Page **0047**  
Register of Deeds Stamp & File Number

Branch (County)	Located In:	Corner Code --#
ALGANSEE TOWNSHIP		
1. Public Land Survey	T <u>7</u> S R <u>5</u> W	J-3
	T _____ R _____	_____
	T _____ R _____	_____
	T _____ R _____	_____
2. Property Controlling in Section	S _____ T _____ R _____	_____
	S _____ T _____ R _____	_____
3. Miscellaneous Property in Sec.	S _____ T _____ R _____	_____
	S _____ T _____ R _____	_____

4. Lot No. \_\_\_\_\_, Recorded Plat \_\_\_\_\_  
5. Private Claims \_\_\_\_\_

I, Edward W. Reed, in a field survey on September 25, 19 95, do hereby certify that under requirements of P.A. 74, Michigan P.A. of 1970, the corner points mentioned in lines 1 and 2 above were in conformance with regulations and rules therefore as required in the current manual of survey instructions of the United States Department of the Interior, Bureau of Land Management or by a decree of a Court of Law and/or that the corner points mentioned in lines 3, 4 and 5 above were in conformance with the rules of the Michigan Board of Land Surveyors or by a Decree of a Court of Law; established, re-established, monumented, re-monumented, recovered, found as expressed below:

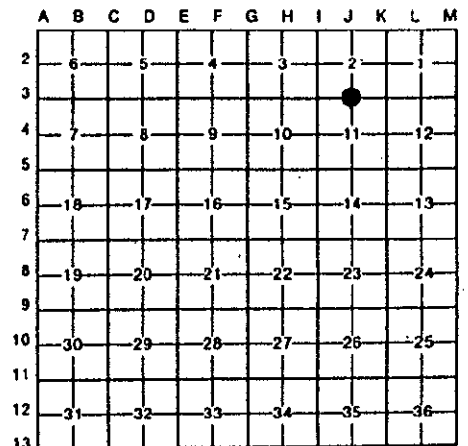


**NOTE: Not more than 4 corners, all in the same town and range, may be recorded on this certificate.**

**A. Description of original monument and accessories and/or subsequent restoration:**  
Quarter corner common to Sections 2 and 11, Town 7 South, Range 5 West, Algansee Township, Branch County, Michigan.  
1826: Brookfield, corner set  
1878: Knowles, found stone  
1979: E. R. Reed, found pointed stone with broken bricks, recorded #234

**B. Description of corner evidence found and/or method applied in restoring or reestablishing corner:**  
Found 3/4" iron as described in #234  
Set remonumentation cap over 3/4" iron and set cast iron box flush with road surface

ACCEPTED BY THE BRANCH COUNTY SURVEY PEER GROUP AS THE OFFICIAL CORNER UNDER MICHIGAN PUBLIC ACT 345 OF 1990 AT MEETING HELD ON Nov. 07, 1995  
E. R. Reed, Co. Rep.

**C. Description of monument for corner and accessories established to perpetuate locating the position of the corner:**  
3/4" iron as noted above:  
N 32 E 52.8' corner of telephone pedestal  
N 20 E 66.7' S end center CMP drive culvert  
S 39 E 45.2' telephone pedestal  
N 10 W 113.40' nail and washer 2' up E side of 12" maple

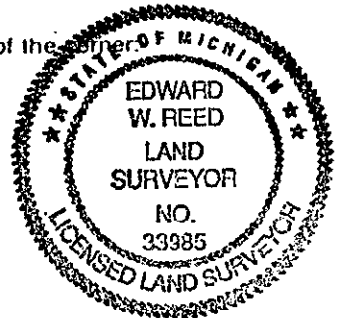

And is accepted as a careful and faithful perpetuation of the position of the original corner.

Signed by Edward W. Reed Date September 25, 1995  
Surveyor's Michigan License No. 33985