

1993

COMMISSIONER BRANCH COUNTY REMONUMENTATION CORNER
LAND CORNER RECORDATION CERTIFICATE
Filing Requirement of Act 74, Mich. P.A. 1970

For corners in

BRANCH (County)	Located In:	Corner Code #
1. Public Land Survey	T <u>7</u> S R <u>6</u> W	<u>C - 2</u>
	T _____ R _____	_____
	T _____ R _____	_____
	T _____ R _____	_____
2. Property Controlling in Section	S _____ T _____ R _____	_____
	S _____ T _____ R _____	_____
3. Miscellaneous Property in Sec.	S _____ T _____ R _____	_____
	S _____ T _____ R _____	_____

REC'D FOR RECORD
STATE OF MICHIGAN
BRANCH COUNTY

93 DEC 27 AM 10:07

Joseph P. Morrison
REGISTER OF DEEDS


265

Register of Deeds Stamp & File Number

4. Lot No. _____, Recorded Plat _____
5. Private Claims _____

I, EDWARD R. REED, in a field survey on NOVEMBER 5, 19 93, do hereby certify that under requirements of P.A. 74, Michigan P.A. of 1970, the corner points mentioned in lines 1 and 2 above were in conformance with regulations and rules therefore as required in the current manual of survey instructions of the United States Department of the Interior, Bureau of Land Management or by a decree of a Court of Law and/or that the corner points mentioned in lines 3, 4 and 5 above were in conformance with the rules of the Michigan Board of Land Surveyors or by a Decree of a Court of Law; established, re-established, monumented, re-monumented, recovered, found as expressed below:

NOTE: Not more than 4 corners, all in the same town and range, may be recorded on this certificate.

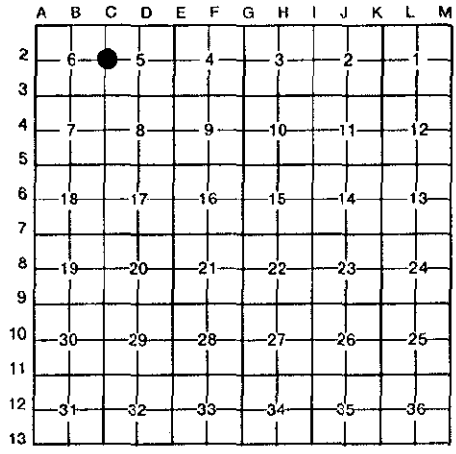

A. Description of original monument and accessories and/or subsequent restoration:

Nov., 1825. W. Brookfield, GLO Dep. Surveyor:
"North between Sec's. 5 & 6
40.00 Set qtr sec post
Beech 15 S27E 25 Beech 10 N21E 15"

11/03/1871. M. Knowles, Dep. County Surveyor:
"Set stakes at T" (W $\frac{1}{4}$ cor Section 5). 1/129, Surveyor's Records
Section corner record file = "Stone W $\frac{1}{4}$ corner Sec 5".
No other information is available for this corner.

B. Description of corner evidence found and/or method applied in restoring or reestablishing corner:

Dug in center of highway over large (6' x 6') area, but could not find stone as noted above.
I found numerous pieces of china or pottery in a small pile at a depth of 22" which is below the road gravel and in a dark soil area surrounded by light sand soil.
I accepted this evidence and reestablished this corner at the location marked by the china (pottery) since this location also fits the proportioned distance for the quarter section line, between the south line of the section and a fenceline marking the occupied north 1/16 line of Section 6 for more that 39 years.
Set a $\frac{1}{2}$ " x 18" rebar iron rod with I.D. cap #7437 in monument box at this location.


C. Description of monument for corner and accessories established to perpetuate locating the position of the corner:

$\frac{1}{2}$ " x 18" rebar iron rod with I.D. cap #7437, over stone, in monument box.:

SE cor Telephone Ped. - West 24.75' 14" Walnut - N 37 W 68.35' to center.
38" Maple - N 84 W 26.9' to center. 20" W. Cherry - N 30 W 95.8' to center.
44" Maple - S 40 W 51.2' to center.
10.3' north of line of north wall of garage to west.

This is accepted as a careful and faithful reestablishment of the position of the original corner.

Signed by *Edward R. Reed*
Surveyor's Michigan License No. 7437

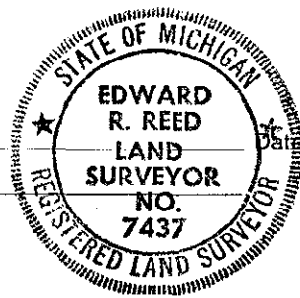

11/05/93