

1993

BRANCH COUNTY REMONUMENTATION CORNER

COMMISSION

LAND CORNER RECORDATION CERTIFICATE

Filing Requirement of Act 74, Mich. P.A. 1970

For corners in

BRANCH (County)	Located In:	Corner Code -#
1. Public Land Survey	T 7 S R 6 W	C - 5
	T R	
	T R	
	T R	
2. Property Controlling in Section	S T R	
	S T R	
3. Miscellaneous Property in Sec.	S T R	
	S T R	
4. Lot No. _____, Recorded Plat _____		
5. Private Claims _____		

REC'D FOR RECORD
STATE OF MICHIGAN
BRANCH COUNTY


93 DEC 27 AM 10:07

REGISTER OF DEEDS

266

Register of Deeds Stamp & File Number

I, EDWARD R. REED in a field survey on OCTOBER 25, 19 93, do hereby certify that under requirements of P.A. 74, Michigan P.A. of 1970, the corner points mentioned in lines 1 and 2 above were in conformance with regulations and rules therefore as required in the current manual of survey instructions of the United States Department of the Interior, Bureau of Land Management or by a decree of a Court of Law and/or that the corner points mentioned in lines 3, 4 and 5 above were in conformance with the rules of the Michigan Board of Land Surveyors or by a Decree of a Court of Law; established, re-established, monumented, re-monumented, recovered, found as expressed below:

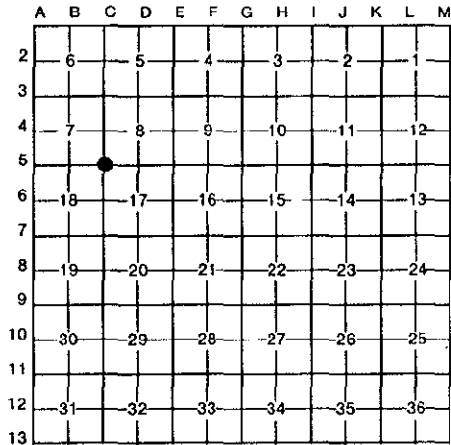

NOTE: Not more than 4 corners, all in the same town and range, may be recorded on this certificate.

A. Description of original monument and accessories and/or subsequent restoration:

SECTION CORNER COMMON TO SECTIONS 7-8-17-18, OVID TOWNSHIP, T7S, R6W.

GLO = Nov. 1825, W. Brookfield, Dep. Surveyor:
" 80.00 Set post cor sec. 7, 8, 17 & 18
W. Oak 7 N 3 1/2 E 17 W Oak 8 S 65 1/2 W 17 "

My Section corner record card file = " Stone ".

B. Description of corner evidence found and/or method applied in restoring or reestablishing corner:

Found very old, badly rusted, iron stake set vertically, 14" below road surface. Continued to dig for stone to depth of 30", but did not find same. Road grade has been lowered this area, with 18" of gravel roadbed, indicating stone may have been removed.


I accepted iron stake as location of corner.
Set 1/2" x 18" rebar iron rod with I.D. cap, in monument box.

C. Description of monument for corner and accessories established to perpetuate locating the position of the corner:

- 1/2" x 18" rebar iron rod with I.D. cap in monument box:
- N 88 E 315.6' - Tag & nail in wood floor @ C/L, north side of wood box culvert.
- N 86 E 294.1' - Top, SW cor., westerly most steel I-beam of guardrail N. side of road.
- S 85 E 284.3' - Top, NW cor., westerly most steel I-beam of guardrail, south side of road.
- S 50 W 35.2' - C/L west end of CMP driveway culvert.
- S 10 W 25.5' - C/L east end of CMP driveway culvert.
- 1.2' north of road C/L.

And is accepted as a careful and faithful perpetuation of the position of the original corner

Signed by Edward R. Reed
Surveyor's Michigan License No. 7437

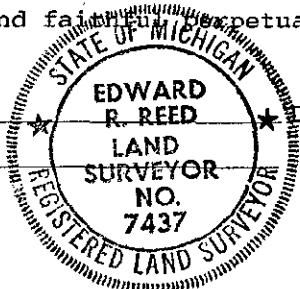

Date 10/25/93