

SECTION

BRANCH COUNTY REMONUMENTATION PROGRAM  
LAND CORNER RECORDATION CERTIFICATE STATE OF MICHIGAN  
Filing Requirement of Act 74, Mich. P.A. 1970 Branch County  
Recorded

For corners in

BRANCH COUNTY OVID TWP. <small>(County)</small>	Located In:	Corner Code #
1. Public Land Survey	T <u>7S</u> R <u>6 W</u>	<u>D-1</u>
	T _____ R _____	_____
	T _____ R _____	_____
	T _____ R _____	_____
2. Property Controlling in Section	S _____ T _____ R _____	_____
	S _____ T _____ R _____	_____
3. Miscellaneous Property in Sec.	S _____ T _____ R _____	_____
	S _____ T _____ R _____	_____

12-30-1999 11:03:12

Linda Lee Morrison-Mathews  
REGISTER OF DEEDS

Liber **00004** Page **0066**

Register of Deeds Stamp & File Number

- 4. Lot No. \_\_\_\_\_, Recorded Plat \_\_\_\_\_
- 5. Private Claims \_\_\_\_\_

A	B	C	D	E	F	G	H	I	J	K	L	M
2	6	5	4	3	2	1						
3												
4	7	8	9	10	11	12						
5												
6	18	17	16	15	14	13						
7												
8	19	20	21	22	23	24						
9												
10	30	29	28	27	26	25						
11												
12	31	32	33	34	35	36						
13												

I, EDWARD W. REED in a field survey on OCT. 20, 19 99, do hereby certify that under requirements of P.A. 74, Michigan P.A. of 1970, the corner points mentioned in lines 1 and 2 above were in conformance with regulations and rules therefore as required in the current manual of survey instructions of the United States Department of the Interior, Bureau of Land Management or by a decree of a Court of Law and/or that the corner points mentioned in lines 3, 4 and 5 above were in conformance with the rules of the Michigan Board of Land Surveyors or by a Decree of a Court of Law; established, re-established, monumented, re-monumented, recovered, found as expressed below:

**NOTE: Not more than 4 corners, all in the same town and range, may be recorded on this certificate.**

A. Description of original monument and accessories and/or subsequent restoration:  
NORTH QUARTER CORNER SECTION 5, OVID TWP.


- 1825: WM. BROOKFIELD-CORNER SET
- 1871: M. KNOWLES-SURVEY OF SECTION 5
- 1878: M. KNOWLES-SET STONE 16 & STONES AROUND 1.33 CHAINS EAST OF 1/4 POST OF SECTION 32

B. Description of corner evidence found and/or method applied in restoring or reestablishing corner:  
NO EVIDENCE OF CORNER  
SET POINT ON LINE AND @ OFFSET DISTANCE AS DESCRIBED BY KNOWLES (1.33 CHAINS) EAST OF COLDWATER QUARTER CORNER  
SET 1/2" x 18" REBAR & REMON CAP IN CAST IRON BOX FLUSH WITH PAVED ROAD SURFACE

ACCEPTED BY THE BRANCH COUNTY SURVEY PEER GROUP AS THE OFFICIAL CORNER UNDER MICHIGAN PUBLIC ACT 345 OF 1990 AT A MEETING HELD ON 12-07-1999

E.R.Reed, P.S.  
E.R. REED

C. Description of monument for corner and accessories established to perpetuate locating the position of the corner:  
1/2" x 18" REBAR & REMON CAP IN CAST IRON BOX FLUSH WITH PAVED ROAD SURFACE  
4" TWIN PINE S61E 60.0'  
8" CEDAR S78W 99.60'  
TELEPHONE PEDESTAL N51E 42.45'  
STEEL CORNER POST N64W 93.65'  
COLDWATER CORNER WEST  
1' NORTH OF CENTERLINE EAST-WEST ROAD

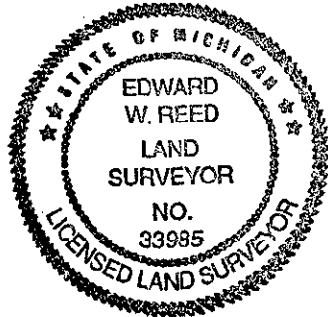

AND IS ACCEPTED AS A CAREFUL AND FAITHFUL REESTABLISHMENT OF THE POSITION OF THE ORIGINAL CORNER.

Signed by Edward W. Reed Date OCTOBER 20, 1999  
Surveyor's Michigan License No. EDWARD W. REED 33985