

# SURVEY & REMONUMENTATION

ACCEPTED BY THE BRANCH COUNTY  
SURVEY PEER GROUP AS THE OFFICIAL  
CORNER UNDER MICHIGAN PUBLIC ACT 345  
OF 1990 AT A MEETING HELD ON  
12-16-94

BRANCH COUNTY REMONUMENTATION CORNER  
LAND CORNER RECORDATION CERTIFICATE  
Filing Requirements MICHIGAN 74, Mich. P.A. 1970

E. R. Reed, Co. Rep.

For corners in

Branch <small>(County)</small>	Located In:	Corner Code <i>≠</i> <i>≠</i>	
1. Public Land Survey	T <u>7</u> S R <u>6</u> W	<u>D-5</u>	
	T _____ R _____	_____	_____
	T _____ R _____	_____	_____
	T _____ R _____	_____	_____
2. Property Controlling in Section	S _____ T _____ R _____	_____	_____
	S _____ T _____ R _____	_____	_____
3. Miscellaneous Property in Sec.	S _____ T _____ R _____	_____	_____
	S _____ T _____ R _____	_____	_____


STATE OF MICHIGAN  
Branch County  
Recorded

12-23-1994 15:07:09

Linda M. [unclear] Registrar of Deeds  
0332

Register of Deeds Stamp & File Number

4. Lot No. \_\_\_\_\_, Recorded Plat \_\_\_\_\_  
5. Private Claims \_\_\_\_\_

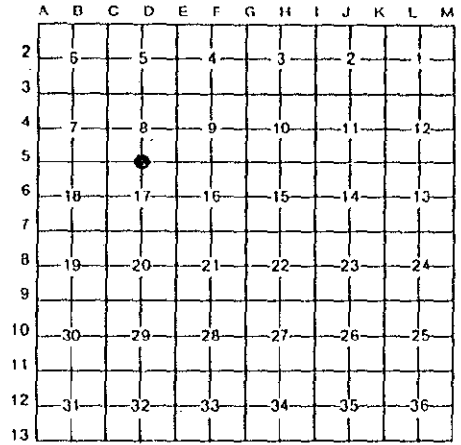

I, Edward W. Reed, in a field survey on September 21, 1994, do hereby certify that under requirements of P.A. 74, Michigan P.A. of 1970, the corner points mentioned in lines 1 and 2 above were in conformance with regulations and rules therefore as required in the current manual of survey instructions of the United States Department of the Interior, Bureau of Land Management or by a decree of a Court of Law and/or that the corner points mentioned in lines 3, 4 and 5 above were in conformance with the rules of the Michigan Board of Land Surveyors or by a Decree of a Court of Law; established, re-established, monumented, re-monumented, recovered, found as expressed below:

**NOTE: Not more than 4 corners, all in the same town and range, may be recorded on this certificate.**

**A. Description of original monument and accessories and/or subsequent restoration:**

Quarter corner common to Sections 8 and 17, Town 7 South, Range 6 West, Ovid, Branch County, Michigan

1825: GLO notes, set post at 40 chains

1856: Survey #99 in County Surveyor's Record, found corner

1959: E. R. Reed, iron pipe

Plat of "Whitewood Shores" tied to North 1/4 corner of Section 17


1971: E. R. Reed, found iron set by self and used many times, recorded #0022

**B. Description of corner evidence found and/or method applied in restoring or reestablishing corner:**

Found 1/2" iron placed in old pipe agreeing with old witness

Placed remonumentation cap on top of iron

Set cast iron monument box flush with road surface

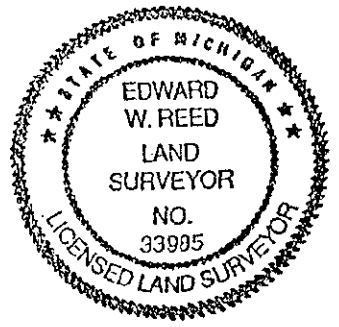

**C. Description of monument for corner and accessories established to perpetuate locating the position of the corner:**

Centerline of East-West Roads

South 70 East 74.9-center of 20" ash

South 1° West 22.79-face of railroad tie fence corner post

North 1° West 31.14'-face of power pole

South 73° East 88.5-36" walnut

North 87 East 218.6'-face of power pole

And is accepted as a careful and faithful perpetuation of the position of the original corner.

Signed by Edward W. Reed Date September 21, 1994  
Surveyor's Michigan License No. 33985