

ACCEPTED BY THE BRANCH COUNTY SURVEY PEER GROUP AS THE OFFICIAL CORNER UNDER MICHIGAN PUBLIC ACT 311 OF 1990 AT A MEETING HELD ON 12-16-94

Edward W. Reed, Co. 1 Rep.

SURVEY & REMONUMENTATION

BRANCH COUNTY REMONUMENTATION CORNER

APR 26 1995

LAND CORNER RECORDATION CERTIFICATE

Filing Requirement of Act 74, Mich. P.A. 1970

COMMISSION

For corners in

Branch	Located In:	Corner Code
OID TOWNSHIP		
1. Public Land Survey	T <u>7</u> S R <u>6</u> W	D-13
	T _____ R _____	_____
	T _____ R _____	_____
	T _____ R _____	_____
2. Property Controlling in Section	S _____ T _____ R _____	_____
	S _____ T _____ R _____	_____
3. Miscellaneous Property in Sec.	S _____ T _____ R _____	_____
	S _____ T _____ R _____	_____

STATE OF MICHIGAN
Branch County
Recorded

12-28-1994 15:07:17

LIBRE 00002-0333
REGISTER OF DEEDS

Register of Deeds Stamp & File Number

4. Lot No. _____, Recorded Plat _____
5. Private Claims _____

	A	B	C	D	E	F	G	H	I	J	K	L	M
2	6	5	4	3	2	1							
3													
4	7	8	9	10	11	12							
5													
6	18	17	16	15	14	13							
7													
8	19	20	21	22	23	24							
9													
10	30	29	28	27	26	25							
11													
12	31	32	33	34	35	36							
13													

I, Edward W. Reed, in a field survey on December 12, 19 94, do hereby certify that under requirements of P.A. 74, Michigan P.A. of 1970, the corner points mentioned in lines 1 and 2 above were in conformance with regulations and rules therefore as required in the current manual of survey instructions of the United States Department of the Interior, Bureau of Land Management or by a decree of a Court of Law and/or that the corner points mentioned in lines 3, 4 and 5 above were in conformance with the rules of the Michigan Board of Land Surveyors or by a Decree of a Court of Law; established, re-established, monumented, re-monumented, recovered, found as expressed below:

NOTE: Not more than 4 corners, all in the same town and range, may be recorded on this certificate.

A. Description of original monument and accessories and/or subsequent restoration:


Quarter corner common to Section 32, Ovid Township, and Section 5, Kinderhook Township, Branch County, Michigan.
1825: Brookfield, corner set
1872: Hamilton, no notes given

B. Description of corner evidence found and/or method applied in restoring or reestablishing corner:

Found 1" x 17" solid iron, nothing beneath iron, east and west measurements agrees, existing fenceline north and south agrees. Best possible evidence of original corner.
Removed 1" iron and set 1/2" x 18" rebar iron, remonumentation cap, and cast iron box 2 1/2" below grade of gravel road

C. Description of monument for corner and accessories established to perpetuate locating the position of the corner:

S 40 W 27.51' nail and washer 2' up north side 50" oak
S 75 E 257.0' nail and washer 2' up north side of 50" oak
Due S 2.5' centerline East-West road
North 47.6' nail and washer up 2' South side 10" twin maple

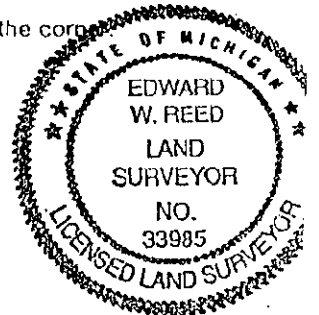

And is accepted as a careful and faithful perpetuation of the position of the original corner.

Signed by Edward W. Reed Date December 12, 1994

Surveyor's Michigan License No. 33985
EDWARD W. REED